

TALLAHATCHIE

NO. 14

8-20-70

MISSISSIPPI BOARD OF WATER COMMISSIONERS  
416 North State Street  
Jackson, Mississippi 39201

CODED

WATER WELL DRILLERS LOG

BUTANE GAS CO. OF GREENWOOD Tallahatchie

8/20/70 19 date well completed firm name county well located

LANDOWNER:	description of formations encountered	from	to
Doc West G.W. Glen dora Miss. (mailing address)	CLAY SAND + GRAVEL SAND	0 10 74	10 74 84
<b>WELL LOCATION:</b> sec. <u>20</u> T. <u>23</u> N. R. <u>2</u> <u>087</u> <u>1</u> miles <u>W</u> of <u>Glen dora</u> (distance) (direction) (nearest town)			
<b>WELL PURPOSE:</b> <u>IND.</u> (home, irrigation, municipal, industrial)			
<b>WELL COMPLETION DATA:</b>			
(1) diameter (inches) <u>4"</u>			
(2) total depth (feet) <u>84</u>			
(3) static water level (feet) <u>18</u> below top of ground.			
(4) casing <u>Steel</u> , <u>74'</u> (material) (depth) <u>4"</u> (size) if telescope see back.			
(5) screen <u>10'</u> , <u>74'</u> (length) (depth to top)			
<u>2"</u> , <u>Stainless Steel</u> (size) (material)			
(6) pump <u>1 1/2</u> , <u>30</u> (HP) (yield gpm)			
<u>Elec.</u> (type power)			
(7) electric log <u>NO</u> (yes or no)			
(organization running log)			
(8) how well bottom plugged <u>Back Pressure Valve</u>			
DRILLERS REMARKS:			


CODED

SEP 1 1970

MISS. BD. OF WATER COMM.

If well telescopes please sketch and show depths.

GROUND LEVEL

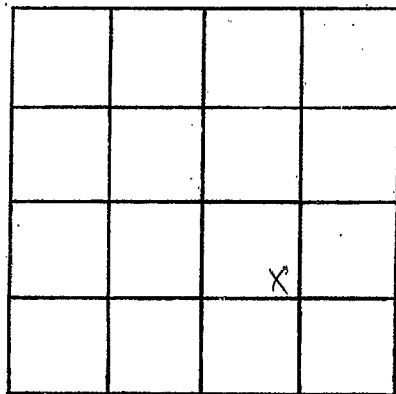

SECTION 20

Please indicate well location X.

ADDITIONAL INFORMATION

If more than one screen, show locations of each on sketch.