

N-15  
6-3-60

WATER WELL DRILLERS LOG

Date: June 3, 1960, Driller: Layne-Central Company **CODED**  
(Name)

331 332

(1) Owner of Land: Buford Plantation  
(Name)  
Glendora, Mississippi  
(Address)  
(2) Location:  $\frac{1}{4}$ , 34 35 36 N  
35 36 37 W  $\frac{1}{4}$ , Sec 35, T. 24  
5 miles west of Glendora  
(distance) (direction) (Nearest Town)  
(3) Topography: flat  
(Hilly) (Flat) (Level)  
(4) Purpose of Well: irrigation  
(Domestic Irrigation  
Municipal, Industrial, Other)

| Description & Color of Materials<br>Sand, Clay, Red Clay, Shell, etc. | Thick-<br>ness<br>Feet | Depth<br>Feet |
|---|------------------------|---------------|
| Clay  | 8                      | 8             |
| Sand  | 8                      | 16            |
| Clay  | 7                      | 23            |
| Coarse sand   | 17                     | 40            |
| Sand, pea gravel  | 15                     | 55            |
| Pea gravel & gravel   | 57                     | 112           |

Information upon completion of well:


(1) Diameter 16 inches.  
(2) Total Depth 112 feet.  
(3) Water Level 13' - 2" feet below top of  
ground.  
(4) Cased to 62', Size 16".  
(5) Screen: Size 16", Length 50'.  
(6) Were any formations sealed against pollution?  
                 yes,   X   no.

If YES depth of formation \_\_\_\_\_

Why \_\_\_\_\_

Drillers Remarks: \_\_\_\_\_

**CODED**

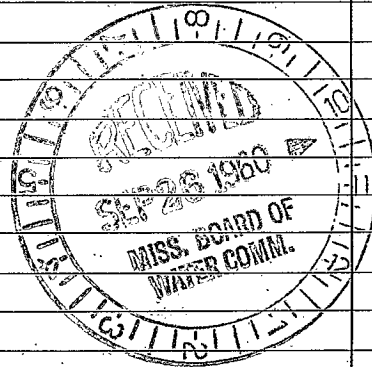

(Use Back Side)

Well No.

