

Tallahatchie  
N 16  
3-3-72

MISSISSIPPI  
BOARD OF WATER COMMISSIONERS  
416 North State Street  
Jackson, Mississippi 39201

WATER WELL DRILLERS LOG

3/3/72 19 date well completed BUTANE GAS CO. OF GREENWOOD TALLAHATCHIE firm name county well located

LANDOWNER:  
M.P. Sturdivant PLT. Co.  
Glendora  
(mailing address)

description of formations encountered	from	to
CLAY	0	18
SAND	18	60
SAND & GRAVEL	60	80

WELL LOCATION:  
sec. 14 T 23 N R. 2 E  
S W  
3 1/2 miles NW of Glendora  
(distance) (direction) (nearest town)

WELL PURPOSE: IRRIGATION  
(home, irrigation, municipal, industrial)

WELL COMPLETION DATA:

(1) diameter (inches) 12"

(2) total depth (feet) 80

(3) static water level (feet) 18 below top of ground.

(4) casing Steel 60  
(material) (depth)  
12" if telescope see back.  
(size)

(5) screen 20 60  
(length) (depth to top)  
12" Steel  
(size) (material)

(6) pump 40 1200  
(HP) (yield gpm)  
LP GAS  
(type power)

(7) electric log No  
(yes or no)


(organization running log)

(8) how well bottom plugged Steel Plate

DRILLERS REMARKS:

If well telescopes please sketch and show depths.

GROUND LEVEL

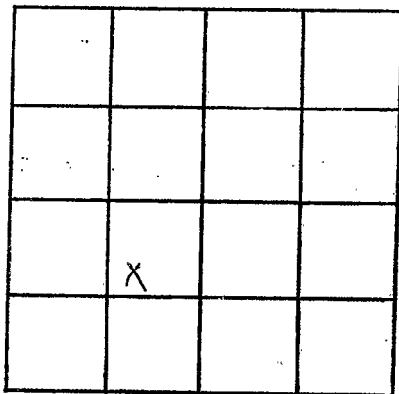

SECTION 12

Please indicate well location X.

ADDITIONAL INFORMATION

If more than one screen,  
show locations of each on sketch.