

Tallahatchie
 N 17
 3-7-72

MISSISSIPPI
 BOARD OF WATER COMMISSIONERS
 416 North State Street
 Jackson, Mississippi 39201

MAR 27 1972

WATER WELL DRILLERS LOG

3/7/72 19 BUTANE GAS CO. OF GREENWOOD Tallahatchie
 date well completed firm name county well located

LANDOWNER:	description of formations encountered	from	to
M. P. STURDIVANT Planting Co.	CLAY	0	25
Glendora	SAND	25	60
(mailing address)	SAND & GRAVEL	60	80

WELL LOCATION:
 sec. 12 T. 23 N R. 2 E
 S W
4 miles NW of Glendora
 (distance) (direction) (nearest town)


WELL PURPOSE: F.R.
 (home, irrigation, municipal, industrial)

- WELL COMPLETION DATA:
- (1) diameter (inches) 12"
 - (2) total depth (feet) 80
 - (3) static water level (feet) 18 below above top of ground.
 - (4) casing Steel, 60
 (material) (depth)
12 if telescope see back.
 (size)
 - (5) screen 20', 60
 (length) (depth to top)
 - 12", Steel
 (size) (material)
 - (6) pump 40, 1200
 (HP) (yield gpm)
LP GAS
 (type power)
 - (7) electric log No
 (yes or no)
 - (organization running log)
 - (8) how well bottom plugged steel
plate

DRILLERS REMARKS:

If well telescopes please sketch and show depths.

GROUND LEVEL

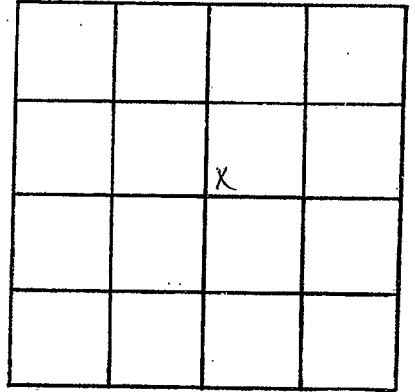

SECTION 12

Please indicate well location X.

ADDITIONAL INFORMATION

If more than one screen,
show locations of each on sketch.