

Tallahatchie
 N18
 3-15-72

MISSISSIPPI
 BOARD OF WATER COMMISSIONERS
 416 North State Street
 Jackson, Mississippi 39201

MAR 27 1972

WATER WELL DRILLERS LOG

3/15/72
 date well completed

19 BUTANE GAS CO. OF GREENWOOD Tallahatchie


firm name

county well located

LANDOWNER:	description of formations encountered	from	to
M.P. Sturdivant Planting Co.	Clay	0	18
Glendora	Sand	18	60
(mailing address)	Sand + Gravel	60	96
WELL LOCATION:			
sec. 13 T 23 N R 2 E			
3 miles NW of Glendora (distance) (direction) (nearest town)			
WELL PURPOSE: IRR			
(home, irrigation, municipal, industrial)			
WELL COMPLETION DATA:			
(1) diameter (inches) 12			
(2) total depth (feet) 96			
(3) static water level (feet) 18 below top of ground.			
(4) casing Steel 76 (material) (depth)			
12" if telescope see back. (size)			
(5) screen 20 76 (length) (depth to top)			
12" Steel (size) (material)			
(6) pump 40 1200 (HP) (yield gpm)			
LP GAS (type power)			
(7) electric log NO (yes or no)			
(organization running log)			
(8) how well bottom plugged Steel Plate			
DRILLERS REMARKS:			

If well telescopes please sketch and show depths.

GROUND LEVEL

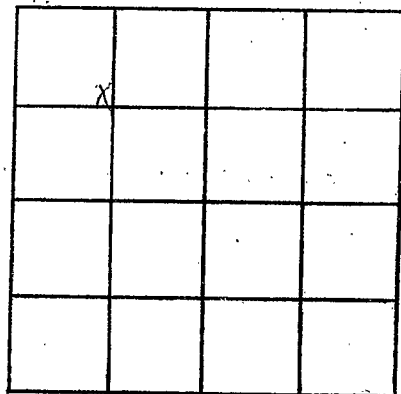

SECTION 13

Please indicate well location X.

ADDITIONAL INFORMATION

If more than one screen,
show locations of each on sketch.