

TALLAHATCHIE
 N 19
 5-3-72

MISSISSIPPI
 BOARD OF WATER COMMISSIONERS
 416 North State Street
 Jackson, Mississippi 39201

CODED

WATER WELL DRILLERS LOG

5/3 1972 McIntosh Well & Supply Co. Sunflower
 date well completed firm name county well located

LANDOWNER:
Charles McRae
R-23-1 - Cat 312
Drew, Miss.
 (mailing address)

WELL LOCATION:
 sec. 23 T 23 R 9
5 miles west of Shannon
 (distance) (direction) (nearest town)

WELL PURPOSE: Home
 (home, irrigation, municipal, industrial)

- WELL COMPLETION DATA:
- (1) diameter (inches) 4x2
 - (2) total depth (feet) 822
 - (3) static water level (feet) 6 below/above top of ground.
 - (4) casing gal. pipe (material) (depth)
 (size) if telescope see back.
 - (5) screen 20 (length) (depth to top)
2 1/2" stainless steel (size) (material)
 - (6) pump 1/2 (HP) 19 (yield gpm)
elec (type power)
 - (7) electric log no (yes or no)
 (organization running log)
 - (8) how well bottom plugged B.P. Belva

description of formations encountered	depth	
	from	to
Top soil	0	27
Sand	27	109
Gravel	109	147
Clay	147	163
Sand	163	207
Clay shale	207	347
Sand	347	407
Shale & Rocks	407	767
Sand	767	822

CODED



MAY 11 1972
 MISS. BD. OF
 WATER COMMISSIONERS

DRILLERS REMARKS:

MISS. BD. OF
 WATER COMMISSIONERS

If well telescopes please sketch and show depths.

GROUND LEVEL

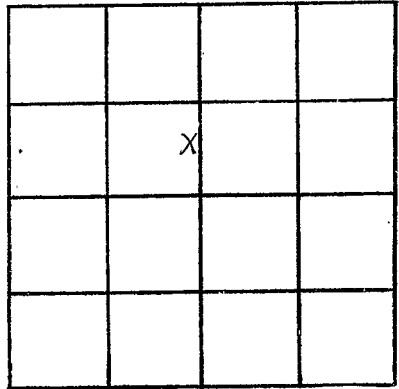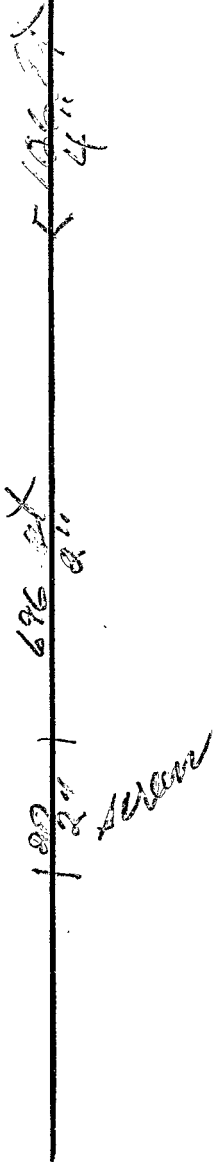

SECTION 22

Please indicate well location X.

ADDITIONAL INFORMATION

If more than one screen, show locations of each on sketch.