

Tallahatchie
 N 20
 6-67

MISSISSIPPI
 BOARD OF WATER COMMISSIONERS
 416 North State Street
 Jackson, Mississippi 39201

CODED

WATER WELL DRILLERS LOG

6/13 1967 Delta Well Supply Co. Tallahatchie
 date well completed firm name county well located

LANDOWNER:
 J. C. Bufford
 Glendon, Miss.
 (mailing address)


description of formations encountered	from	to
Clay	0	13
Hard Sand	13	40
Coarse	40	98
Sand Rocks	98	123

WELL LOCATION:
 sec. 14 23 N R. 2 E
 4 miles N.W. of Glendon
 (distance) (direction) (nearest town)

WELL PURPOSE: Irrigation
 (home, irrigation, municipal, industrial)

- WELL COMPLETION DATA:
- (1) diameter (inches) 16
 - (2) total depth (feet) 123
 - (3) static water level (feet) 18 below top of ground.
 - (4) casing steel, 13 (material), (depth)
 16 (size) if telescope see back.
 - (5) screen 40, 63 (length), (depth to top)
 16, Steel (size), (material)
 - (6) pump 20, 3000 (HP), (yield gpm)
 I.P. Hus Engine (type power)
 - (7) electric log (yes-or no)
 (organization running log)
 - (8) how well bottom plugged

CODED

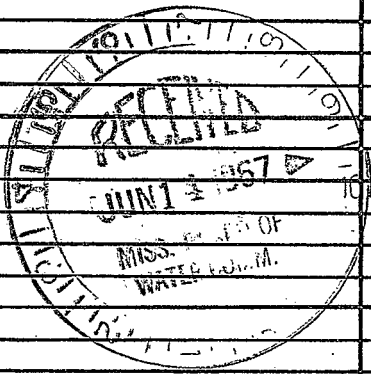

DRILLERS REMARKS:

If well telescopes please sketch and show depths.

GROUND LEVEL

		X	

SECTION 14

Please indicate well location X.

ADDITIONAL INFORMATION

If more than one screen, show locations of each on sketch.