

Tallahatchie
 N 28
 66-77

MISSISSIPPI
 BOARD OF WATER COMMISSIONERS
 416 North State Street
 Jackson, Mississippi 39201

CODED

WATER WELL DRILLERS LOG

6-6-1977 LAYNE CENTRAL CO. Tallahatchie
 date well completed firm name county well located

LANDOWNER: Billy Joe Waldrup
 Drew, MS

description of formations encountered	from	to
Clay	0	20
log (wood)	20	22
fine sand	22	35
coarse sand	35	46
coarse sand & pea gravel	46	63
coarse sand	63	68
coarse sand & gravel	68	75
sand (med.) coarse	75	79
coarse sand & gravel	79	84
coarse sand & big gravel	84	106

(mailing address)

WELL LOCATION:
 In Southwest Tallahatchie County
 sec. 17 T. 23 N R. 2 W
 6 miles NE of Drew
 (distance) (direction) (nearest town)

WELL PURPOSE: Irrigation
 (home, irrigation, municipal, industrial)

WELL COMPLETION DATA:

- (1) diameter (inches) 16"
- (2) total depth (feet) 106'
- (3) static water level (feet) 18' 6" below top of ground.
- (4) casing Steel 56'
 (material) (depth)
 16" if telescope see back.
 (size)
- (5) screen 50' 56'
 (length) (depth to top)
 16" St. Steel
 (size) (material)
- (6) pump 60 3,000
 (HP) (yield gpm)
 diesel
 (type power)
- (7) electric log No
 (yes or no)
- (organization running log)
- (8) how well bottom plugged St. Plate


RECEIVED
 AUG 8 1977

DRILLERS REMARKS:

MISS. BD. OF WATER COMMISSIONERS

If well telescopes please sketch and show depths.

GROUND LEVEL

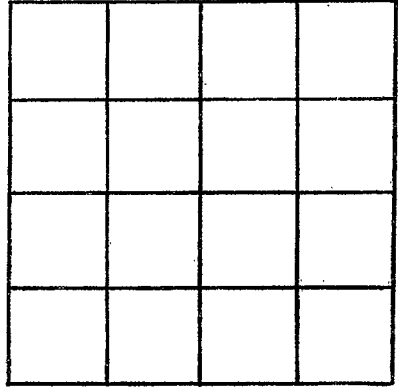

SECTION _____

Please indicate well location X.

ADDITIONAL INFORMATION

If more than one screen,
show locations of each on sketch.