

TALLAHATCHIE
 N 29
 5-10-77

MISSISSIPPI
 BOARD OF WATER COMMISSIONERS
 416 North State Street
 Jackson, Mississippi 39201

CODED

WATER WELL DRILLERS LOG

5-10 date well completed 1977 Fines County Farmers firm name Tallahatchie county well located

LANDOWNER: RAY HAUSNER

description of formations encountered

from to

Webb Miss
 (mailing address)

<u>Top soil & clay</u>		<u>12</u>
<u>Fine sand</u>	<u>12</u>	<u>32</u>
<u>Coarse sand</u>	<u>32</u>	<u>48</u>
<u>Sand & Gravel</u>	<u>48</u>	<u>92</u>

WELL LOCATION:

sec 2 T 23 N R 2 E
 S W
3 1/2 miles SOUTH of Webb
 (distance) (direction) (nearest town)

WELL PURPOSE: drinking
 (home, irrigation, municipal, industrial)

CODED

WELL COMPLETION DATA:

- (1) diameter (inches) 6"
- (2) total depth (feet) 92'
- (3) static water level (feet) 18 ^{below}/_{above} top of ground.
- (4) casing BLACK PIPE 60'
 (material) (depth)

 If telescope see back.
 (size)

- (5) screen 32 , 60'
 (length) (depth to top)
6" , Down
 (size) (material)

- (6) pump 40 1200
 (HP) (yield gpm)
TRACTOR
 (type power)

- (7) electric log NO
 (yes or no)

 (organization running log)

- (8) how well bottom plugged welded


DRILLERS REMARKS:

RECEIVED
 OCT - 6 1977

MISS. BD. OF WATER COMMISSIONERS

If well telescopes please sketch and show depths.

GROUND LEVEL

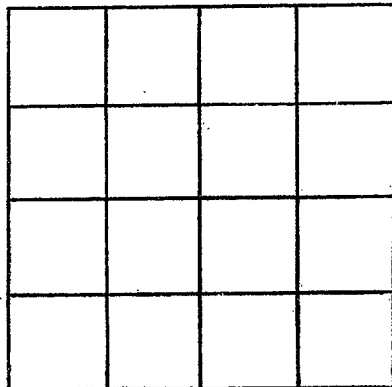

SECTION _____

Please indicate well location X.

ADDITIONAL INFORMATION

If more than one screen,
show locations of each on sketch.