

MISSISSIPPI
BOARD OF WATER COMMISSIONERS
416 North State Street
Jackson, Mississippi 39201

CODED

WATER WELL DRILLERS LOG

TALLAHATCHIE
N 31
6-23-77

6-23-77 1977 Five Counties Foreman Tallahatchie
date well completed firm name county well located

LANDOWNER: Paul Melton
W.S. Kincaid
Webb
(mailing address)

description of formations encountered	from	to
top Soil & clay		12
fine sand	12	45
sand & gra	45	96

WELL LOCATION:
sec 10 T 23 N R 2 E
7 miles South of Webb
(distance) (direction) (nearest town)

CODED		
-------	--	--

WELL PURPOSE: Irrigation
(home, irrigation, municipal, industrial)

- WELL COMPLETION DATA:
- (1) diameter (inches) 6"
 - (2) total depth (feet) 96'
 - (3) static water level (feet) 13 ^{below} top of ground.
 - (4) casing BK PIPE 56 (material) (depth)
6" (size) if telescope see back.
 - (5) screen 40' (length) 56 (depth to top)
6" (size) BK LOUVER (material)
 - (6) pump 40 (HP) 1200 (yield gpm)
Tractor (type power)
 - (7) electric log 10 (yes or no)
 - (organization running log)
 - (8) how well bottom plugged Welded


CODED		
-------	--	--

DRILLERS REMARKS:

RECEIVED
OCT - 6 1977
WATER COMMISSION

If well telescopes please sketch and show depths.

GROUND LEVEL

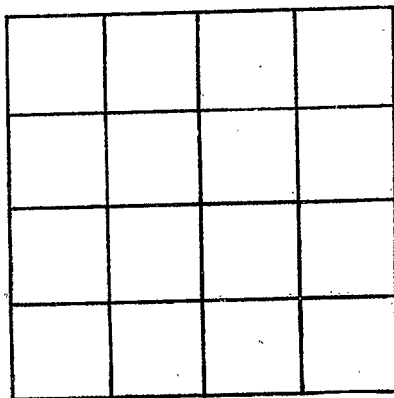

SECTION _____

Please indicate well location X.

ADDITIONAL INFORMATION

If more than one screen, show locations of each on sketch.