

TALLAHATCHIE
 N 32,
 6-24-77

MISSISSIPPI
 BOARD OF WATER COMMISSIONERS
 416 North State Street
 Jackson, Mississippi 39201

WATER WELL DRILLERS LOG

CODED

6-24 date well completed 19 77 firm name Five County Farm Drilling county well located

LANDOWNER: W.S. Hancock
Rented - Paul Melton
Webb
 (mailing address)

description of formations encountered	from	to
<u>top soil & loam</u>		<u>12</u>
<u>fine sand</u>	<u>12</u>	<u>42</u>
<u>sand & gravel</u>	<u>42</u>	<u>93</u>

WELL LOCATION:
 sec. 10 T. 23 N R. 2 E
7 miles South of Webb
 (distance) (direction) (nearest town)

WELL PURPOSE: drinking
 (home, irrigation, municipal, industrial)

- WELL COMPLETION DATA:
- (1) diameter (inches) 6"
 - (2) total depth (feet) 93
 - (3) static water level (feet) 13 below above top of ground.
 - (4) casing BLK PIPE 53
 (material) (depth)
6" if telescope see back.
 (size)
 - (5) screen 40', 53
 (length) (depth to top)
6", LOUVER
 (size) (material)
 - (6) pump 40 1200
 (HP) (yield gpm)
Tractor
 (type power)
 - (7) electric log NO
 (yes or no)
 - (8) how well bottom plugged Welded


CODED

RECEIVED
 OCT - 8 1977

DRILLERS REMARKS:

If well telescopes please
sketch and show depths.

GROUND LEVEL

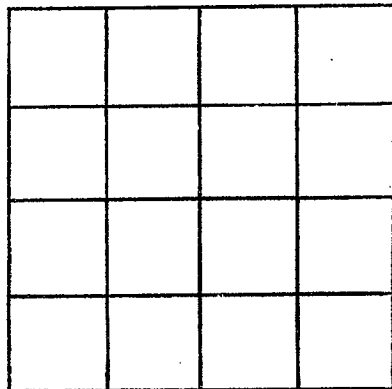

SECTION _____

Please indicate well location X.

ADDITIONAL INFORMATION

If more than one screen,
show locations of each on sketch.