

Tallahatchie

SUNFLOWER

N 37

2/28/78

MISSISSIPPI BOARD OF WATER COMMISSIONERS
416 North State Street
Jackson, Mississippi 39201

CODED

WATER WELL DRILLERS LOG

Tallahatchie

February 28 1978 Dyer Well & Irrigation

Sunflower

date well completed

firm name

county well located

LANDOWNER: Billy Joe Waldrup

description of formations encountered

from

to

R.R. 2 Box 440

Draw, Miss 38737
(mailing address)

WELL LOCATION:

sec. 6 T-23 (N) R-2 E ?
S W

6 miles East of Gladora
(distance) (direction) (nearest town)

WELL PURPOSE: Irrigation
(home, irrigation, municipal, industrial)

WELL COMPLETION DATA:

- (1) diameter (inches) 16"
- (2) total depth (feet) 113'
- (3) static water level (feet) 18' below top of ground.
- (4) casing Steel 73'
(material) (depth)
16" If telescope see back.
(size)
- (5) screen 40' 73'
(length) (depth to top)
16" Steel
(size) (material)
- (6) pump 60 3000
(HP) (yield gpm)
Diesel
(type power)
- (7) electric log No
(yes or no)

(organization running log)

(8) how well bottom plugged Plate

DRILLERS REMARKS:

| | | | |
|---------------|-------|----|-----|
| Clay | | 0 | 13 |
| Clay | CODED | 14 | 23 |
| Clay | | 24 | 33 |
| Fine Sand | | 34 | 57 |
| SAND + GRAVEL | | 59 | 113 |

Bottom 113'


Miss. Board of Water Comm.

FEB 28 1978

WATER WELL

If well telescopes please sketch and show depths.

GROUND LEVEL

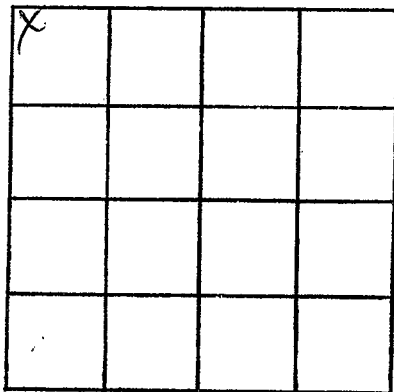

SECTION 6

Please indicate well location X.

ADDITIONAL INFORMATION

If more than one screen,
show locations of each on sketch.