

MISSISSIPPI DEPARTMENT OF NATURAL RESOURCES

Bureau of Land and Water Resources

Southport Mall

P.O. Box 10631

Jackson, Mississippi 39209

CODED

WATER WELL DRILLERS LOG

Tallahatchie
N40
10/7/81
GW 4133

10-7
date well completed


1981 Dyer Well + Irrigation
firm name

Tallahatchie
county well located

LANDOWNER: <u>H.T. Miller</u>	description of formations encountered	from	to
<u>Drew, Miss.</u> (mailing address)	<u>Clay</u>	<u>2</u>	<u>17</u>
WELL LOCATION: sec. <u>28</u> T <u>23</u> (N) R <u>2</u> E <u>6</u> miles <u>W</u> of <u>Clendon</u> (distance) (direction) (nearest town)	<u>fine sand</u>	<u>17</u>	<u>30</u>
WELL PURPOSE: <u>irrigation</u> (home, irrigation, municipal, industrial)	<u>sand</u>	<u>30</u>	<u>48</u>
WELL COMPLETION DATA:	<u>sand & gravel</u>	<u>48</u>	<u>108</u>
(1) diameter (inches) <u>16"</u>	CODED		
(2) total depth (feet) <u>108'</u>			
(3) static water level (feet) <u>21'</u> below above top of ground.			
(4) casing: <u>Steel</u> , <u>68'</u> , (material) (depth)			
<u>16"</u> if telescope see back. (size)			
(5) screen: <u>40'</u> , <u>68'</u> (length) (depth to top)			
<u>16"</u> , <u>Mild Steel</u> (size) (material)			
(6) pump <u>60</u> <u>3000</u> (HP) (yield gpm)			
<u>Butane</u> (type power)			
(7) electric log <u>No</u> (yes or no)			
<u>None</u> (organization running log)			
(8) how well bottom plugged <u>Plate</u>			
DRILLERS REMARKS:	DEPT. OF NATURAL RESOURCES BUREAU OF LAND & WATER RESOURCES OCT 15 1981 RECEIVED		

If well telescopes please sketch and show depths.

GROUND LEVEL

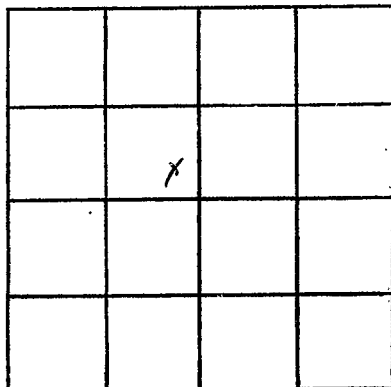

SECTION 28

Please indicate well location X.

ADDITIONAL INFORMATION

If more than one screen,
show locations of each on sketch.