

MISSISSIPPI DEPARTMENT OF NATURAL RESOURCES

Bureau of Land and Water Resources

Southport Mall

P.O. Box 10631

Jackson, Mississippi 39209

WATER WELL DRILLERS LOG

CODED

N 44

TALLAHATCHIE

11-2-83

11-2
date well completed

1983

BUTANE GAS COMPANY
OF GREENWOOD

Tallahatchie
county well located

LANDOWNER:	description of formations encountered	from	to
Ralph Hand	Clay	0	10
Glendora (mailing address)	sand sand & gravel	10 60	60 103
WELL LOCATION:			
sec. <u>23</u> T <u>23</u> N R <u>2</u> E S W			
<u>5</u> miles <u>NW</u> of <u>Glendora</u> (distance) (direction) (nearest town)			
WELL PURPOSE: <u>Domestic</u> (home, irrigation, municipal, industrial)			
WELL COMPLETION DATA:			
(1) diameter (inches) <u>12"</u>			
(2) total depth (feet) <u>103</u>			
(3) static water level (feet) <u>35</u> below above top of ground.			
(4) casing <u>Steel, 63'</u> (material) (depth)			
<u>12"</u> if telescope see back. (size)			
(5) screen <u>40</u> , <u>63</u> (length) (depth to top)			
<u>12"</u> , <u>steel</u> (size) (material)			
(6) pump <u>60</u> <u>700</u> (HP) (yield gpm)			
<u>Diesel</u> (type power)			
(7) electric log <u>No</u> (yes or no)			
<u>No</u> (organization running log)			
(8) how well bottom plugged <u>Steel plate</u>			
DRILLERS REMARKS:			
<u>Carlos Ramos</u>			

CODED

DEPT. OF NATURAL RESOURCES
BUREAU OF LAND & WATER RESOURCES


NOV 14 1983

RECEIVED

If well telescopes please sketch and show depths.

GROUND LEVEL

SECTION 23
ENGINEERING

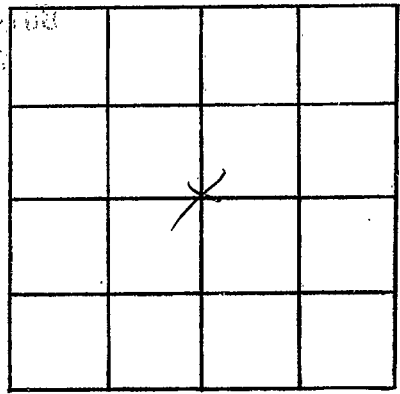

SECTION 23

Please indicate well location X.

ADDITIONAL INFORMATION

If more than one screen,
show locations of each on sketch.