

MISSISSIPPI DEPARTMENT OF NATURAL RESOURCES
 Bureau of Land and Water Resources
 Southport Mall
 P.O. Box 10631
 Jackson, Mississippi 39209
 WATER WELL DRILLERS LOG

9

N45
 Tallahatchie
 2-13-84

CODED

Tallahatchie
~~Sumner~~
 county well located

2/13/84 19 Powell Formation
 date well completed firm name

LANDOWNER: H.T. Miller

| description of formations encountered | from | to |
|---------------------------------------|------|-----|
| | CLAY | 0 |
| FINE SAND | 13 | 43 |
| COARSE SAND & GRAVEL | 43 | 103 |

Drew Miss
 (mailing address)

WELL LOCATION:
 sec 30 T 23 (N) R 2 E
 S W
 6 miles East of Drew
 (distance) (direction) (nearest town)

WELL PURPOSE: Irrigation
 (home, irrigation, municipal, industrial)

WELL COMPLETION DATA:

- (1) diameter (inches) 16"
- (2) total depth (feet) 103'
- (3) static water level (feet) 28' below above top of ground.
- (4) casing Steel, 63' (material) (depth)
- (size) If telescope see back.
- (5) screen 40' 63' (length) (depth to top)
- 1 1/2" Steel (size) (material)
- (6) pump 60 2000 (HP) (yield gpm)
- Diesel (type power)
- (7) electric log NO (yes or no)
- (organization running log)
- (8) how well bottom plugged Steel plate

DRILLERS REMARKS:


DEPT. OF NATURAL RESOURCES
 BUREAU OF LAND & WATER RESOURCES

MAR 23 1984

RECEIVED

If well telescopes please sketch and show depths.

GROUND LEVEL

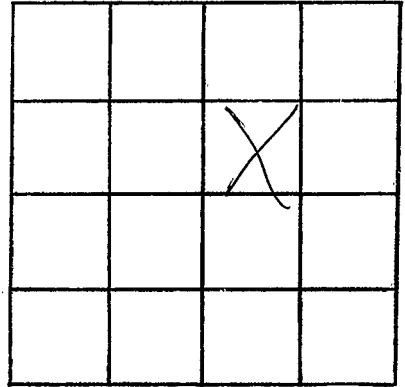

SECTION 30

Please indicate well location X.

ADDITIONAL INFORMATION

If more than one screen,
show locations of each on sketch.