

MISSISSIPPI DEPARTMENT OF NATURAL RESOURCES
Bureau of Land and Water Resources

Southport Mall

P.O. Box 10631

Jackson, Mississippi 39209

WATER WELL DRILLERS LOG

CODED

N46
Tallahatchie
6-6-84

6-6-84
date well completed

J. K. Irrigator Well
firm name

Tallahatchie
county well located

LANDOWNER:
Greenwood Irrigation
(mailing address)

description of formations encountered	from	to
CLAY	0	20

WELL LOCATION:
sec. 2 T. 23 N. R. 2 E
S (W)
5 miles SW of Webb
(distance) (direction) (nearest town)

LIME SAND	20	32
SAND Gravel	32	103

WELL PURPOSE:
(home, irrigation, municipal, industrial)

WELL COMPLETION DATA:

(1) diameter (inches) 12

(2) total depth (feet) 103

(3) static water level (feet) 23' below above top of ground.

(4) casing steel 63
(material) (depth)
12 if telescope see back.
(size)

(5) screen 40 63
(length) (depth to top)
12 steel
(size) (material)

(6) pump 110 1500
(HP) (yield gpm)
diesel
(type power)

(7) electric log no
(yes or no)
(organization running log)

(8) how well bottom plugged plate

CODED

DEPT. OF NATURAL RESOURCES
BUREAU OF LAND & WATER RESOURCES


JUL 12 1984

DRILLERS REMARKS:

RECEIVED

If well telescopes please sketch and show depths.

GROUND LEVEL

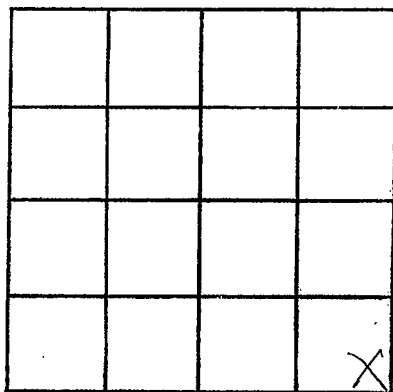

SECTION 2

Please indicate well location X.

ADDITIONAL INFORMATION

If more than one screen,
show locations of each on sketch.