

MISSISSIPPI DEPARTMENT OF NATURAL RESOURCES

Bureau of Land and Water Resources

Southport Mall

P.O. Box 10631

Jackson, Mississippi 39209

WATER WELL DRILLERS LOG

N 47
Tallahatchie
6-12-84

CODED

Tallahatchie

6/12 1984
date well completed

1984

Rawell Irrigation
firm name

county well located

LANDOWNER: Armstead

(mailing address)

description of formations encountered	from	to
CLAY	0	20
CLAY + Brown Sand	20	40
Medium Sand	40	60
Coarse Sand + Gravel	60	100

WELL LOCATION:
sec. 1 T 24 S R 2 E
1/2 miles NE of Summer
(distance) (direction) (nearest town)

WELL PURPOSE: Irrigation
(home, irrigation, municipal, industrial)

WELL COMPLETION DATA:

(1) diameter (inches) 12"

(2) total depth (feet) 100'

(3) static water level (feet) 18' below above top of ground.

(4) casing Steel (material), 60' (depth)
(size) If telescope see back.

(5) screen 40' (length), 60' (depth to top)
12" (size), Steel (material)

(6) pump 20 (HP), 1900 (yield gpm)
diesel (type power)

(7) electric log NO (yes or no)
(organization running log)

(8) how well bottom plugged Steel Plate

CODED

DEPT. OF NATURAL RESOURCES
BUREAU OF LAND & WATER RESOURCES


JUL 10 1984

RECEIVED

DRILLERS REMARKS:

If well telescopes please sketch and show depths.

GROUND LEVEL

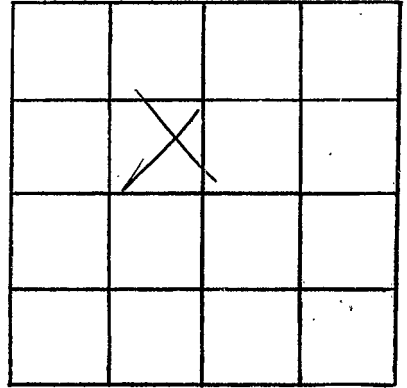

SECTION 1

Please indicate well location X.

ADDITIONAL INFORMATION

If more than one screen,
show locations of each on sketch.