

MISSISSIPPI DEPARTMENT OF NATURAL RESOURCES

Bureau of Land and Water Resources

Southport Mall

P.O. Box 10631

Jackson, Mississippi 39209

WATER WELL DRILLERS LOG

N 48
Tallahatchie
6-13-84

CODED

6-13-1984 date well completed Powell Irrigation firm name Tallahatchie county well located

LANDOWNER: Armistead

description of formations encountered	from	to
clay	0	20
Brown sand	20	50
Coarse sand & gravel	50	97

(mailing address)

WELL LOCATION:
 sec. 24 T N R 2 E
 S 1/2 miles NE of Summer
 (distance) (direction) (nearest town)

WELL PURPOSE: Irrigation
 (home, irrigation, municipal, industrial)

WELL COMPLETION DATA:

- (1) diameter (inches) 12"
- (2) total depth (feet) 97'
- (3) static water level (feet) 18' ^{below} / _{above} top of ground.
- (4) casing Steel, 57'
 (material) (depth)
 (size) If telescope see back.
- (5) screen 40', 57'
 (length) (depth to top)
12", Steel
 (size) (material)
- (6) pump 80 7400
 (HP) (yield gpm)
diesel
 (type power)
- (7) electric log NO
 (yes or no)
 (organization running log)

(8) how well bottom plugged Steel pipe

DRILLERS REMARKS:

CODED


DEPT. OF NATURAL RESOURCES
 BUREAU OF LAND & WATER RESOURCES

JUL 10 1984

RECEIVED

If well telescopes please sketch and show depths.

GROUND LEVEL

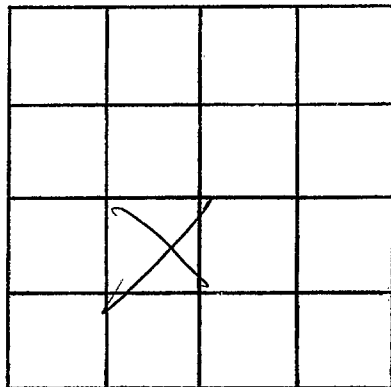

SECTION 1

Please indicate well location X.

ADDITIONAL INFORMATION

If more than one screen,
show locations of each on sketch.