

MISSISSIPPI DEPARTMENT OF NATURAL RESOURCES
Bureau of Land and Water Resources
 Southport Mall
 P.O. Box 10631
 Jackson, Mississippi 39209
WATER WELL DRILLERS LOG

CODED

N49
Tallahatchie
2/25/84

Feb 25 19 84 Larry's Well & pump Tallahatchie
 date well completed m name county well located

LANDOWNER: Doug Williams
 (mailing address)

description of formations encountered	from	to
<u>slay</u>	<u>0</u>	<u>30</u>
<u>Sand</u>	<u>30</u>	<u>50</u>
<u>Sand & gravel</u>	<u>50</u>	<u>100</u>

WELL LOCATION:
 sec. 5 T 23 (N) R 2 (W) E
5 miles WEST of Webb
 (distance) (direction) (nearest town)

WELL PURPOSE:
 (home, irrigation, municipal, industrial)

WELL COMPLETION DATA:

(1) diameter (inches) 16"

(2) total depth (feet) 100'

(3) static water level (feet) 22 below above top of ground.

(4) casing Steel, 60',
 (material) (depth)
 (size) If telescope see back.

(5) screen 40', 60'
 (length) (depth to top)
16", steel
 (size) (material)

(6) pump 20, 1200
 (HP) (yield gpm)
0
 (type power)

(7) electric log NO
 (yes or no)

(organization running log)

(8) how well bottom plugged Steel Plate

DRILLERS REMARKS:

CODED


DEPT. OF NATURAL RESOURCES
 BUREAU OF LAND & WATER RESOURCES

AUG 20 1984

RECEIVED

If well telescopes please
sketch and show depths.

GROUND LEVEL

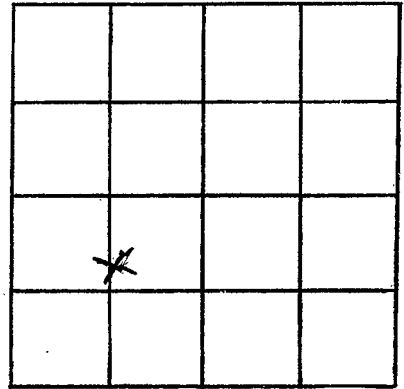

SECTION 5

Please indicate well location X.

ADDITIONAL INFORMATION

If more than one screen,
show locations of each on sketch.