

MISSISSIPPI DEPARTMENT OF NATURAL RESOURCES
 Bureau of Land and Water Resources
 Southport Mall
 P.O. Box 10631
 Jackson, Mississippi 39209
WATER WELL DRILLERS LOG

CODED

N50
Tallahatchie
2/25/84

Feb 25 19 84 Larry's well & pump Tallahatchie
 date well completed firm name county well located

LANDOWNER: Ray Williams
 (mailing address)

description of formations encountered	from	to
<u>slay</u>	<u>0</u>	<u>30</u>
<u>sub</u>	<u>30</u>	<u>60</u>
<u>coarse sand</u>	<u>60</u>	<u>115</u>

WELL LOCATION:
 sec. S T. 23 (N) R. E
S miles WEST of WEBB
 (distance) (direction) (nearest town)

WELL PURPOSE:
 (home, irrigation, municipal, industrial)

CODED

WELL COMPLETION DATA:
 (1) diameter (inches) 16"
 (2) total depth (feet) 115'
 (3) static water level (feet) 22 below top of ground.
 (4) casing Steel 75'
 (material) (depth)
 (size) if telescope see back.
 (5) screen 40' 75'
 (length) (depth to top)
16" steel
 (size) (material)
 (6) pump 60 1200
 (HP) (yield gpm)
b
 (type power)
 (7) electric log No
 (yes or no)
 (organization running log)

(8) how well bottom plugged Steel Plate

DRILLERS REMARKS:


DEPT. OF NATURAL RESOURCES
 BUREAU OF LAND & WATER RESOURCES

AUG 20 1984

RECEIVED

If well telescopes please sketch and show depths.

GROUND LEVEL

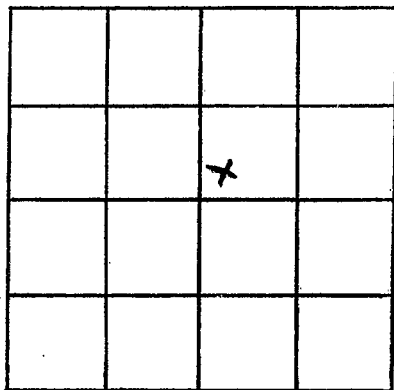

SECTION 5

Please indicate well location X.

ADDITIONAL INFORMATION

If more than one screen, show locations of each on sketch.