

MISSISSIPPI DEPARTMENT OF NATURAL RESOURCES

Bureau of Land and Water Resources

Southport Mall

P.O. Box 10631

Jackson, Mississippi 39209

WATER WELL DRILLERS LOG

CODED

N 51
Tallahatchie
2/23/84

Feb 23 19 84 Larry's well & pump Tallahatchie
date well completed firm name county well located

LANDOWNER: Doug Williams

description of formations encountered	from	to
clay	0	30
sand	30	50
coarse sand	50	100

(mailing address)

WELL LOCATION:

sec. 5 T. 23 N. R. 2 W.
5 miles WEST of Webb
(distance) (direction) (nearest town)

WELL PURPOSE:
(home, irrigation, municipal, industrial)

WELL COMPLETION DATA:

- (1) diameter (inches) 16"
- (2) total depth (feet) 100'
- (3) static water level (feet) 22 ^{below}/_{above} top of ground.
- (4) casing steel 60'
(material) (depth)
(size) if telescope see back.
- (5) screen 40' 60'
(length) (depth to top)
16" steel
(size) (material)
- (6) pump 60 1200
(HP) (yield gpm)
D
(type power)
- (7) electric log no
(yes or no)

(organization running log)

(8) how well bottom plugged Steel Plate

DRILLERS REMARKS:

CODED


DEPT. OF NATURAL RESOURCES
BUREAU OF LAND & WATER RESOURCES

AUG 20 1984

RECEIVED

If well telescopes please
sketch and show depths.

GROUND LEVEL

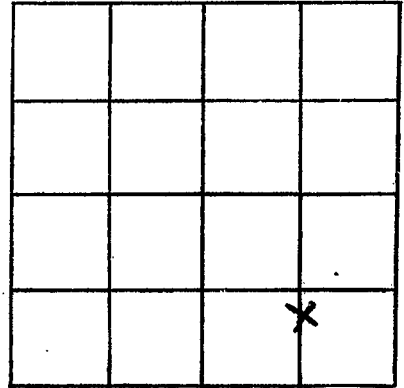

SECTION 5

Please indicate well location X.

ADDITIONAL INFORMATION

If more than one screen,
show locations of each on sketch.