

MISSISSIPPI DEPARTMENT OF NATURAL RESOURCES
Bureau of Land and Water Resources
 Southport Mall
 P.O. Box 10631
 Jackson, Mississippi 39209
WATER WELL DRILLERS LOG

CODED

N52
 TALLAHATCHIE
 8-15-84

8/84 19 POWELL FOR TALLAHATCHIE
 date well completed firm name county well located

LANDOWNER:
 T.C. BUFORD
 Glendora MS
 (mailing address)

| description of formations encountered | from | to |
|---------------------------------------|------|-----|
| CLAY | 0 | 23 |
| BLUE CLAY | 23 | 50 |
| FINE SAND | 50 | 70 |
| COARSE SAND | 70 | 130 |
| * GRAVEL | | |

WELL LOCATION:
 sec. 28 T. 23 N. R. 2 E
 6 miles W of GLENDORA
 (distance) (direction) (nearest town)

WELL PURPOSE: FUEL
 (home, irrigation, municipal, industrial)

WELL COMPLETION DATA:

(1) diameter (inches) 16

(2) total depth (feet) 120

(3) static water level (feet) 24 below above top of ground.

(4) casing Steel, 80 below above top of ground.
 (material) (depth)
 (size) if telescope see back.

(5) screen 16, Steel
 (length) (depth to top)
16, Steel
 (size) (material)

(6) pump 150 2500
 (HP) (yield gpm)
Diesel
 (type power)

(7) electric log NO
 (yes or no)

(organization running log)

(8) how well bottom plugged:
Steel Plate

DRILLERS REMARKS:


DEPT. OF NATURAL RESOURCES
 BUREAU OF LAND & WATER RESOURCES

NOV 29 1984

RECEIVED

If well telescopes please sketch and show depths.

GROUND LEVEL

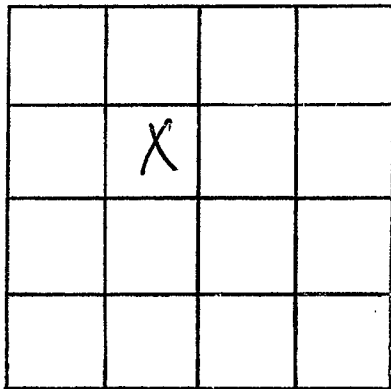

SECTION 28

Please indicate well location X.

ADDITIONAL INFORMATION

If more than one screen,
show locations of each on sketch.