

MISSISSIPPI DEPARTMENT OF NATURAL RESOURCES

Bureau of Land and Water Resources

Southport Mall

P.O. Box 10631

Jackson, Mississippi 39209

WATER WELL DRILLERS LOG

Tallahatchie  
N53

CODED


3-10 19 85 Dyer Well, Inc Tallahatchie  
date well completed firm name county well located

LANDOWNER: William Jales Box 552	description of formations encountered	from	to
Webb, Mrs. 38966 (mailing address)	Clay Fined Sand Sand + Gravel	0 50 58	50 58 96
<b>WELL LOCATION:</b>			
sec. <u>1</u> T <u>23</u> N S R <u>2</u> E W <u>2 1/2</u> miles S of Webb (distance) (direction) (nearest town)			
<b>WELL PURPOSE:</b> <u>Domestic</u> (home, irrigation, municipal, industrial)			
<b>WELL COMPLETION DATA:</b>			
(1) diameter (inches) <u>16"</u>			
(2) total depth (feet) <u>96</u>			
(3) static water level (feet) _____ below above top of ground.			
(4) casing <u>Steel</u> , <u>56'</u> , (material) (depth)			
_____ if telescope see back. (size)			
(5) screen <u>40'</u> , <u>56'</u> (length) (depth to top)			
<u>16"</u> , <u>Steel</u> (size) (material)			
(6) pump <u>60</u> <u>975</u> (HP) (yield gpm)			
<u>Diesel</u> (type power)			
(7) electric log <u>No</u> (yes or no)			
_____ (organization running log)			
(8) how well bottom plugged <u>Steel Plate</u>			
<b>DRILLERS REMARKS:</b>			
_____			
_____			
_____			
_____			

CODED

If well telescopes please sketch and show depths.

GROUND LEVEL

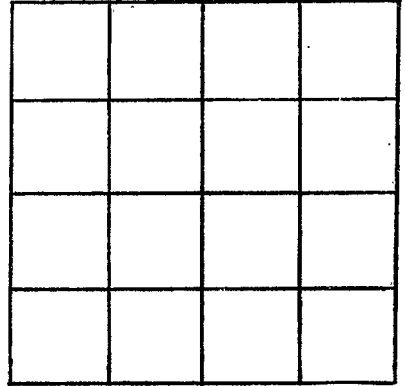

SECTION \_\_\_\_\_

Please indicate well location X.

ADDITIONAL INFORMATION

If more than one screen, show locations of each on sketch.