

MISSISSIPPI DEPARTMENT OF ENVIRONMENTAL QUALITY

Office of Land and Water Resources

COUNTY WELL LOCATED Tallahatchie	
WELL NUMBER N-72	CODED
DATE WELL COMPLETED 5-21-04	

PERMIT NUMBER GW-39696
NAME OF DRILLING FIRM Irrigation Equipment Inc.
Indianola, MS

P. O. Box 10631
Jackson, MS 39289-0631
WATER WELL DRILLERS LOG

NAME & MAILING ADDRESS OF LANDOWNER SSP, LLC c/o Fischer Farm Services Box 926 Aberdeen, MS 39730	
---	--

Latitude:
Longitude:

WELL LOCATION	SEC 13	TOWNSHIP 23N	RANGE 2W
		S	E

DISTANCE 7	DIRECTION South	NEAREST TOWN Webb
Miles	of	

OTHER LANDMARK

WELL PURPOSE: Home, Irrigation, Municipal, Industrial, Fish Pond, etc.
Irrigation Replacement

WELL DATA

Well Depth 116	Casing Diameter (In.) 16	Casing Length (Ft.) 76
--------------------------	------------------------------------	----------------------------------

Type of Casing pvc	Hole Depth 116	Depth to Static Water Level 28ft.
------------------------------	--------------------------	---

TYPE OF COMPLETION: (Circle One or More):
 Gravel Packed, Underreamed, Telescoped,
 Natural Development, Open Hole, Other
 (Describe)

WELL GROUTED TO A DEPTH OF **10** FEET
 Type Grout (circle one): Cement, Bentonite or Mix

SCREEN DATA

Diameter - Inches 16	Length - Feet 40	Slot Size - Inches .050
--------------------------------	----------------------------	-----------------------------------

Screen Type pvc	Depth to Bottom - Feet 116
---------------------------	--------------------------------------

PUMP DATA

PUMP TYPE (Circle One):
 Submersible, Turbine, Jet Flowing Well,
 Other (Describe)

POWER TYPE (Circle One):
 Electric, Tractor, Diesel, Gasoline, Butane,
 Other (Describe) H/P **60**

DESCRIPTION OF FORMATIONS ENCOUNTERED	FROM	TO
Clay	0	35
Fine Sand	36	65
Fine Sand/gravel	66	71
Med. Sand/gravel	72	116

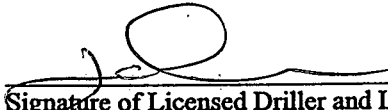
RECEIVED

JUN 15 2004

BY: OLWR

Top of Lap Pipe or Reduction in Casing
FEET IF TELESCOPED OR MORE THAN ONE SCREEN: USE BACK PAGE

I certify that the well was drilled, constructed and completed in accordance with all applicable Requirements of the Mississippi Department of Environmental Quality and/or the Mississippi Department of Health regulations and state laws.

 0439
 Signature of Licensed Driller and License No.

6-10-04
 Date

Additional Information Required On Back

If well telescopes please sketch and show depths.

GROUND LEVEL

	X		

SECTION 13

Please indicate well location X.

Pump Capacity (GPM)	No. of Stages	Setting Depth
2200	2	60 FT.

PUMP TEST

Well yielded _____ GPM with
 a drawdown of _____ ft.
 after _____ hours of pumping

LOG DATA

TYPE OF LOG RUN (Circle One): No Log Run,
 Electric, Gamma Ray, Density, Sonic, Neutron,
 Other (Describe) _____

Name of Organization Running Log _____

GEOLOGIC DATA (Office Use Only)

Surface Elev.	Geologic Unit	Unit Thickness	Depth to Top
Subs. SWL	Date	Analysis	Aquifer Test

Driller's Remarks

If more than one screen,
 show location of each on sketch.