	State Well Report	For Office Use Only:
County: Tallahatchie	Part 1	For Onice Ose Only:
	Mississippi Department of Environmental Quality Aquifer:	
Permit #: 6 W 41657 Mississipp	ice of Land and Water Resources	Well #:
Irrigation Equipment	P.O. Box 10631 Well #:	
7 14 06	Jackson, MS 39289-0631	L. S. Elevation:
Date drilling completed: 7-14-06	(601)961-5210	
	(601)354-6938 (fax)	E-log #:
State Law requires that this report be prej 30 days of completion of drilling of the wel		ith the Department within
Well Owner Information		Location
Owner NameMike Wagner	Latitude: 33,49 49.	8 <u>90 23 45.5,</u> Longitude:
Mailing Address: Box 456	Method of Lat/Long (circle or	
	NUSGS quad, Hand-held	GPS, Survey-grade GPS
Sumner MS 38957	SE 1/4 Sec 28	Twn23N Rng2W
City State Zi	Code Distance Direction	Nearest Town
		of <u>Glendora</u>
Telephone No. ()		
	Well Data	
Date well drilling started: 7-14-06 If flowing, method of flow regulation: Valve	Date well drilling completed: Other (describe)	7-14-06
Static Water Level: 41 feet above or selon	circle one) land surface Date measured:	7-15-06
Method of Measurement (circle one)	electric tape air line other:	
Hole depth: 124 Well depth:	Well grouted to a depth of _	10 feet
Type of grout (circle one): Cement Bentonity	Mix	
Casing length: 84 feet Casing diameter.	16inches Type of casing:	PVC Sch.40
Screen length: 40 feet Screen diameter:	16inches Type of screen:	PVC Sch.40
Screen slot size: <u>050</u> inches Setting d	epth: From 85 feet to	124 <u>fee</u> t
Type of completion (circle all applicable): Gravel page	ked Underreamed Telescoped Open	hole Natural Development
Other (des	cribe):	
Top of lap pipe or reduction in casing:	feet. If telescoped or more than one scre	een, describe on back of page
Logs run (circle all applicable): No log run Electric	Gamma Ray Density Sonic Neutron	Other:
Name of organization running log(s):		
I certify that the well was drilled, constructed, and o	ompleted in accordance with all applicable	requirements of the Mississippi
Department of Environmental Quality and/or the M		
Irrigation Equipment In	C C C C C C C C C C C C C C C C C C C	and state laws.
Patrick M. Chism 0695	" Patil I	o cha

Print Name of Water Well Contractor and License No.

RECEIVED

Signature of Water Well Contractor

JUL 3 1 2006

BY: OLWR


If well telescopes please sketch below and show depths.

Ground Level

Description of Formations Encountered	From	To
Clay	0	30
l Fine Sand	37	45
Fine Sand/gravel	46	55
Med. Sand/gravel	56	24
	11	
	1	$\neg \neg$
	1	-1
	+	
	+	
	╁──┤	
	 	
	1	
<u> </u>		

If more than one screen, show location of each on sketch

Sketch the property layout and include the following: 1) the well location; 2) any permanent structures on the property that may aid in locating the well; 3) any roads, power lines, or other items that may aid in locating the property and the well; 4) indicate direction.

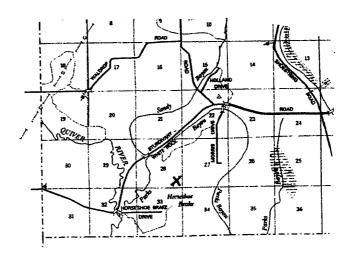

andowner Name:		
angowner Name		

Signature of Water Well Contractor

STATE WELL REPORT

Tallahatchie Permit & W41 Irrigation Equipment Driller:

7-14-06 Date completed:

Copy information from block on Part 1

Part 2

Pump Installer's Completion Report Mississippi Department of Environmental Quality Office of Land and Water Resources P.O. Box 10631 Jackson, MS 39289-0631 (601)961-5210 (601)354-6938 (fax)

For Office Use Only:	
•	
N-16	

	Vell Owner Inform	ation		Well Location	
Owner Name: Mi	ke Wagner		Latitude:	Longitude:_	
Mailing Address:		··	Method of Lat/Lo	ng (check one): Convent	ional Survey,
	Sumner M	G 30057	1 -	Hand-held GPS, Su	
			4	% Sec ²⁸ T 231	$\frac{\sqrt{R}}{2M}$
Cit	•	Zip Code	1	Direction Nearest	
	Pump Type Circle one		1	Power Type Circle one	
Air Lift	Jet .	Submersible	Diesel Engine	Gasoline Engine	Natural Gas
Bucket	Piston	Turbine	Electric Motor	Hand	Tractor PTC
Centrifugal	Rotary	Flowing Well	Windmill	Other (specify):	
Other (specify):			Horse Power Rati	ng of Motor: 60	
Date Pump Installed:	7-15-06		Setting Depth:	80	fect
	2300-300	0 Gallons Per Minute	i i	=1	
	Pump Test Dat	2	Me	ethod of Measuring War	ter Level

l	Pump Test Data	Method of Measuring Water Level Circle one
١	Date Well Tested:	
	Static Water Level (A):Feet Below Land Surface	Air Line Electric Measuring Line Steel Tape
	Pumping Water Level (B):Feet Below Land Surface	Other (specify):
	Drawdown [(B) - (A)]:Feet Below Land Surface	For flowing well, measured shut in head:feet
	Test Pumping Rate: Gallons Per Minute	Well yielded GPM with a drawdown of
	Duration of Pump Test (minimum 4 hours):hours	feet afterhours of pumping

I HEREBY CERTIFY that the above statements are true to the best of my

Patrick M. Chism 0695

Print Name of Pump Installer and License No. (if applicable)

Signature of Pump Installer

Form: OLWR-SWR-1B RECEIVED

JUL 3 1 2006

BY: OLWR