

# State Well Report

Part 1

Mississippi Department of Environmental Quality  
Office of Land and Water Resources  
P.O. Box 10631  
Jackson, MS 39289-0631  
(601)961-5210  
(601)354-6938 (fax)

County: Tallahatchie  
Permit #: (00 42900)  
Driller: Irrigation Equipment  
Date drilling completed: 10-22-08

For Office Use Only:  
Aquifer: \_\_\_\_\_  
Well #: N-87  
L. S. Elevation: \_\_\_\_\_  
E-log #: \_\_\_\_\_

State Law requires that this report be prepared by the driller in detail and filed with the Department within 30 days of completion of drilling of the well.

Well Owner Information	Well Location
Owner Name: <u>Robert Bishop</u>	Latitude: <u>33.50.03</u> Longitude: <u>90.19.02</u>
Mailing Address: <u>Box 355</u>	Method of Lat/Long (circle one): <u>Conventional Survey</u> , USGS quad, Hand-held GPS, Survey-grade GPS
<u>Sumner Ms. 38957</u> City State Zip Code	<u>NW 1/4 NE 1/4 Sec 29 Twn 23N Rng 2W</u>
Telephone No. <u>662 375-8624</u>	Distance Direction Nearest Town <u>7</u> Miles <u>West</u> of <u>Glendora</u>

Well Data

Purpose of Well (circle one) Home Industrial Public Supply Irrigation Fish Culture Other: \_\_\_\_\_

Date well drilling started: 10-22-08 Date well drilling completed: 10-22-08

If flowing, method of flow regulation: Valve \_\_\_\_\_ Other (describe) \_\_\_\_\_

Static Water Level: 46 feet above or below (circle one) land surface Date measured: 10-29-08

Method of Measurement (circle one) steel tape electric tape air line other: \_\_\_\_\_

Hole depth: 127 Well depth: 127 Well grouted to a depth of 10 feet

Type of grout (circle one): Cement Bentonite Mix

Casing length: 87 feet Casing diameter: 12 inches Type of casing: PVC

Screen length: 40 feet Screen diameter: 12 inches Type of screen: PVC

Screen slot size: .050 inches Setting depth: From 88 feet to 127 feet

Type of completion (circle all applicable): Gravel packed Underreamed Telescoped Open hole Natural Development  
Other (describe): \_\_\_\_\_


Top of lap pipe or reduction in casing: \_\_\_\_\_ feet. If telescoped or more than one screen, describe on back of page

Logs run (circle all applicable): No log run Electric Gamma Ray Density Sonic Neutron Other: \_\_\_\_\_

Name of organization running log(s): \_\_\_\_\_

I certify that the well was drilled, constructed, and completed in accordance with all applicable requirements of the Mississippi Department of Environmental Quality and/or the Mississippi Department of Health regulations and state laws.

Irrigation Equipment Inc.  
John P. Chism 0439

Print Name of Water Well Contractor and License No. \_\_\_\_\_ Signature of Water Well Contractor 

RECEIVED  
NOV 05 2008  
BY: OLWR

60042909  
If well telescopes please sketch below and show depths.

N-87

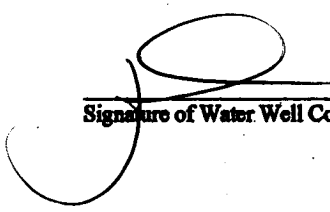
Ground Level

Description of Formations Encountered	From	To
Clay	0	22
Fine Sand	23	37
Fine Sand + Gravel	28	44
Medium Sand + Gravel	45	127

If more than one screen, show location of each on sketch

Sketch the property layout and include the following: 1) the well location; 2) any permanent structures on the property that may aid in locating the well; 3) any roads, power lines, or other items that may aid in locating the property and the well; 4) indicate direction.

Landowner Name: Robert Bishop

  
\_\_\_\_\_  
Signature of Water Well Contractor

RECEIVED  
NOV 05 2008  
BY: OLWR

# STATE WELL REPORT

## Part 2

**Pump Installer's Completion Report**  
 Mississippi Department of Environmental Quality  
 Office of Land and Water Resources  
 P.O. Box 10631  
 Jackson, MS 39289-0631  
 (601)961-5210  
 (601)354-6938 (fax)

County: Tallahatchie  
 Permit #: 1042900  
 Irrigation Equipment  
 Driller: \_\_\_\_\_  
 Date completed: 10-22-08

**For Office Use Only:**

Aquifer: \_\_\_\_\_  
 Well #: N-87  
 Elevation: \_\_\_\_\_

This report should be prepared by the pump installer in detail and filed with the Department within 30 days of the installation of pump.

Well Owner Information	Well Location
Owner Name: <u>Robert Bishop</u>	Latitude: _____ Longitude: _____
Mailing Address: <u>Box 355</u>	Method of Lat/Long (circle one): Conventional Survey, USGS quad, Hand-held GPS, Survey-grade GPS
<u>Sumner Ms 38957</u> City State Zip Code	<u>NW 1/4 NE 1/4 Sec 29 Twn 23N Rng 2W</u>
Telephone No. <u>662 375-8624</u>	Distance Direction Nearest Town <u>7 Miles West of Glendora</u>

Pump Type Circle one	Power Type Circle one
Air Lift Jet Submersible	<u>Diesel Engine</u> Gasoline Engine Natural Gas
Bucket Piston <u>Turbine</u>	Electric Motor Hand Tractor PTO
Centrifugal Rotary Flowing Well	Windmill Other (specify): _____
Other (specify): _____	Horse Power Rating of Motor: <u>40</u>
Date Pump Installed: <u>10-29-08</u>	Setting Depth: <u>80</u> feet
Rated Pump Capacity: <u>1400<sup>±</sup></u> Gallons Per Minute	Number of Stages: <u>2</u>

Pump Test Data	Method of Measuring Water Level Circle one
Date Well Tested: _____	Air Line Electric Measuring Line Steel Tape
Static Water Level (A): _____ Feet Below Land Surface	Other (specify): _____
Pumping Water Level (B): _____ Feet Below Land Surface	For flowing well, measured shut in head: _____ feet
Drawdown [(B) - (A)]: _____ Feet Below Land Surface	Well yielded _____ GPM with a drawdown of _____ feet after _____ hours of pumping
Test Pumping Rate: _____ Gallons Per Minute	
Duration of Pump Test (minimum 4 hours): _____ hours	

I HEREBY CERTIFY that the above statements are true to the best of my knowledge.

John P. Chism 0439  
 Print Name of Pump Installer and License No. (if applicable)

[Signature]  
 Signature of Pump Installer

RECEIVED

NOV 05 2008

BY: OLWR