

Tallahatchie
N2000

MISSISSIPPI
BOARD OF WATER COMMISSIONERS
416 North State Street
Jackson, Mississippi 39201

WATER WELL DRILLERS LOG

8-9-82 19 Austin Cain Well Service Tallahatchie
date well completed firm name county well located

LANDOWNER	description of formations encountered	from	to
Joel Morris Rt 2	Clay	0	19
Glendora Ms (mailing address)	Sand	19	80
WELL LOCATION: sec. 22 T. 23 N. R. 2 E. S. W. 4 1/2 miles W of Glendora (distance) (direction) (nearest town)			
WELL PURPOSE: Home (home, irrigation, municipal, industrial)			
WELL COMPLETION DATA:			
(1) diameter (inches) 4			
(2) total depth (feet) 80			
(3) static water level (feet) 18 below above top of ground.			
(4) casing PVC 80 (material) (depth) (size) If telescope see back.			
(5) screen 10' 70 (length) (depth to top) 4" PVC (size) (material)			
(6) pump 3/4 12 (HP) (yield gpm) ELECT (type power)			
(7) electric log (yes or no)			
(organization running log)			
(8) how well bottom plugged PVC Cap			
DRILLERS REMARKS:			


DEPT. OF NATURAL RESOURCES
BUREAU OF LAND & WATER RESOURCES

AUG 11 1982

RECEIVED

If well telescopes please sketch and show depths.

GROUND LEVEL

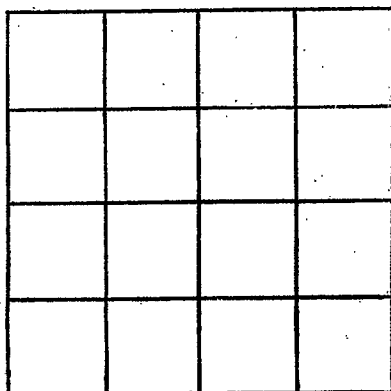

SECTION _____

Please indicate well location X.

ADDITIONAL INFORMATION

If more than one screen,
show locations of each on sketch.