

Jallopatahi
N 2010

MISSISSIPPI DEPARTMENT OF NATURAL RESOURCES
 Bureau of Land and Water Resources
 Southport Mall
 P.O. Box 10631
 Jackson, Mississippi 39209
WATER WELL DRILLERS LOG

4-6 1982 Fin Co. Fanner Ave Jallopatahi
 date well completed firm name county well located

LANDOWNER: H. L. Miller
Drew
 (mailing address)

description of formations encountered	from	to
	<u>top clay</u>	<u>0</u>
<u>fine sand</u>	<u>42</u>	<u>50</u>
<u>Coarse sand</u>	<u>30</u>	<u>60</u>
<u>sand & gravel</u>	<u>65</u>	<u>103</u>

WELL LOCATION:
 sec 22 T 23 N R 2 E
S W
5 miles East of Drew
 (distance) (direction) (nearest town)

WELL PURPOSE:
 (home, irrigation, municipal, industrial)

- WELL COMPLETION DATA:
- (1) diameter (inches) 12"
 - (2) total depth (feet) 103
 - (3) static water level (feet) 28 below above top of ground.
 - (4) casing 12" 53
 (material) (depth)
 - 12 if telescope see back.
 (size)
 - (5) screen 50' 53
 (length) (depth to top)
 - 12" steel Brown
 (size) (material)
 - (6) pump 60 1080
 (HP) (yield gpm)
 - Acad
 (type power)
 - (7) electric log no
 (yes or no)
 - (organization running log)
 - (8) how well bottom plugged well

DRILLERS REMARKS:


DEPT. OF NATURAL RESOURCES
 BUREAU OF LAND & WATER RESOURCES

JUN 23 1982

RECEIVED

If well telescopes please
sketch and show depths.

GROUND LEVEL

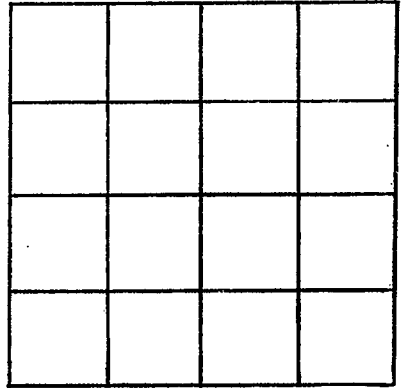

SECTION _____

Please indicate well location X.

ADDITIONAL INFORMATION

If more than one screen,
show locations of each on sketch.