

Jallopateh
N2011-

MISSISSIPPI DEPARTMENT OF NATURAL RESOURCES
 Bureau of Land and Water Resources
 Southport Mall
 P.O. Box 10631
 Jackson, Mississippi 39209
WATER WELL DRILLERS LOG

5-4 1982 Fin Co Farm Co Jallopateh
 date well completed firm name county well located

LANDOWNER: A. J. Miller
Drew Miss
 (mailing address)

description of formations encountered	from	to
	<u>top clay</u>	<u>0</u>
<u>fin. sand</u>	<u>12</u>	<u>28</u>
<u>Coarse sand</u>	<u>28</u>	<u>60</u>
<u>sand & gr</u>	<u>60</u>	<u>100</u>

WELL LOCATION:
 sec. 22-23 N R. 2 E.
5 miles East of Drew
 (distance) (direction) (nearest town)

WELL PURPOSE:
 (home, irrigation, municipal, industrial)


- WELL COMPLETION DATA:
- (1) diameter (inches) 12"
 - (2) total depth (feet) 100
 - (3) static water level (feet) 27 below above top of ground.
 - (4) casing steel 50
 (material) (depth)
12 if telescope see back.
 (size)
 - (5) screen 50 50
 (length) (depth to top)
12" steel Brown
 (size) (material)
 - (6) pump 60 1000
 (HP) (yield gpm)
diaphragm
 (type power)
 - (7) electric log no
 (yes or no)
 - (organization running log)
 - (8) how well bottom plugged welded

DRILLERS REMARKS:

DEPT. OF NATURAL RESOURCES
 BUREAU OF LAND & WATER RESOURCES
 JUN 23 1982
RECEIVED

If well telescopes please sketch and show depths.

GROUND LEVEL

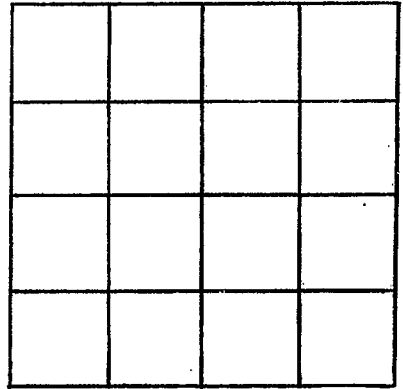

SECTION _____

Please indicate well location X.

ADDITIONAL INFORMATION

If more than one screen,
show locations of each on sketch.