

MISSISSIPPI DEPARTMENT OF NATURAL RESOURCES

Bureau of Land and Water Resources

Southport Mall

P.O. Box 10631

Jackson, Mississippi 39209

WATER WELL DRILLERS LOG *Tallahatchie*

Tallahatchie
N 2012

date well completed

19

Deper Well, + Spring

firm name

county well located

Sunflower

LANDOWNER:

Billy Joe Waldrop

description of formations encountered

from

to

Clay

0

21

Fin Sand

21

27

Sand + gravel

27

123

(mailing address)

WELL LOCATION:

sec. *21* T *23* N R *2* E

S

W

7 miles *W* of *Glendon*

(distance)

(direction)

(nearest town)

WELL PURPOSE:

(home, irrigation, municipal, industrial)

WELL COMPLETION DATA:

(1) diameter (inches) *16*

(2) total depth (feet) *103*

(3) static water level (feet) *16* below above top of ground.

(4) casing *Steel*, *63*, (material) (depth)

(size) if telescope see back.

(5) screen *40'*, *40'* (length) (depth to top)

16", *steel* (size) (material)

(6) pump *125*, *1500* (HP) (yield gpm)

diesel (type power)

(7) electric log *no* (yes or no)

no (organization running log)

(8) how well bottom plugged *plate*

DEPT. OF NATURAL RESOURCES
 BUREAU OF LAND & WATER RESOURCES


FEB - 3 1983

RECEIVED

DRILLERS REMARKS:

If well telescopes please sketch and show depths.

GROUND LEVEL

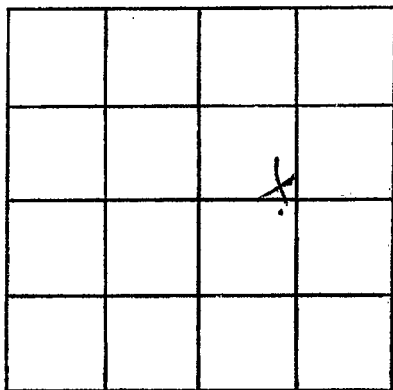

SECTION 21

Please indicate well location X.

ADDITIONAL INFORMATION

If more than one screen,
show locations of each on sketch.