

Tallahatchie
N 2013

MISSISSIPPI DEPARTMENT OF NATURAL RESOURCES

Bureau of Land and Water Resources

Southport Mall

P.O. Box 10631

Jackson, Mississippi 39209

WATER WELL DRILLERS LOG

Tallahatchie
Dunklin

19 80 date well completed

firm name

county well located

LANDOWNER: Billy Joe Welding

Description of formations encountered

from

to

(mailing address)

WELL LOCATION:

sec 20 T 3 N R 2 W
6 miles W of Glendon
 (distance) (direction) (nearest town)

WELL PURPOSE: irrigation
 (home, irrigation, municipal, industrial)

WELL COMPLETION DATA:

(1) diameter (inches) 16
 (2) total depth (feet) 113
 (3) static water level (feet) 16 below above
 top of ground.

(4) casing Steel, 73
 (material) (depth)

_____ if telescope see back.
 (size)

(5) screen 40', 40'
 (length) (depth to top)
16", steel
 (size) (material)

(6) pump 125, 1500
 (HP) (yield gpm)
diesel
 (type power)

(7) electric log no
 (yes or no)
no
 (organization running log)

(8) how well bottom plugged plate

DEPT. OF NATURAL RESOURCES
 BUREAU OF LAND & WATER RESOURCES


FEB - 3 1983

RECEIVED

DRILLERS REMARKS:

If well telescopes please sketch and show depths.

GROUND LEVEL

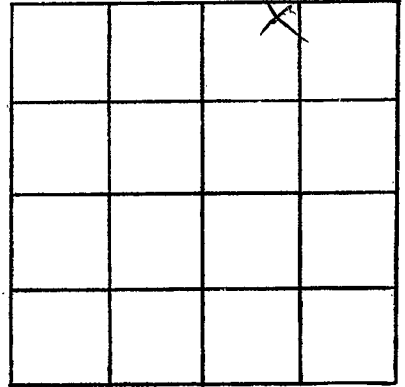

SECTION 20

Please indicate well location X.

ADDITIONAL INFORMATION

If more than one screen,
show locations of each on sketch.