

Tallahatchie
N 2014

MISSISSIPPI DEPARTMENT OF NATURAL RESOURCES

Bureau of Land and Water Resources

Southport Mall

P.O. Box 10631

Jackson, Mississippi 39209

WATER WELL DRILLERS LOG

Tallahatchie
Sumner

19 83
 date well completed

Bayou Wells
 firm name

county well located

LANDOWNER: Billy Joe Waldrop

Description of formations encountered

from

to

Clay	0	26
Fin Sand	26	38
Sand + Gravel	38	100

(mailing address)

WELL LOCATION:

sec 20 T 23 N R 2 E
6 1/2 miles W of Deerdena
 (distance) (direction) (nearest town)

WELL PURPOSE:

(home, irrigation, municipal, industrial)

WELL COMPLETION DATA:

- (1) diameter (inches) 16"
- (2) total depth (feet) 100
- (3) static water level (feet) 16 below above top of ground.
- (4) casing Steel, 60,
 (material) (depth)
 (size) if telescope see back.
- (5) screen 40', 40'
 (length) (depth to top)
16", steel
 (size) (material)
- (6) pump 125 1500
 (HP) (yield gpm)
Diesel
 (type power)
- (7) electric log no
 (yes or no)
no
 (organization running log)
- (8) how well bottom plugged plate

DEPT. OF NATURAL RESOURCES
 BUREAU OF LAND & WATER RESOURCES


FEB - 8 1983

RECEIVED

DRILLERS REMARKS:

If well telescopes please sketch and show depths.

GROUND LEVEL

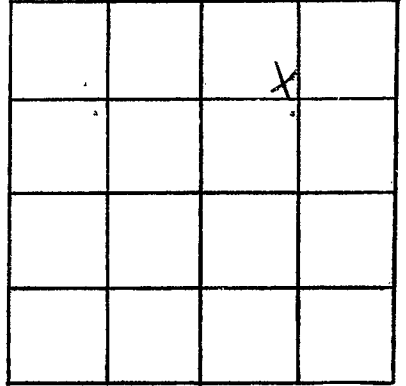

SECTION 20

Please indicate well location X.

ADDITIONAL INFORMATION

If more than one screen,
show locations of each on sketch.