

(cont.)

MISSISSIPPI
BOARD OF WATER COMMISSIONERS
416 North State Street
Jackson, Mississippi 39201

WATER WELL DRILLERS LOG

12-12-69 19 WIFE WELL CO. TALLAHATCHIE
date well completed firm name county well located

LANDOWNER:
John Gould
Glendora, Miss
(mailing address)

WELL LOCATION:
sec. — T — N R — E
S W 807'
_____ miles _____ of _____
(distance) (direction) (nearest town)

WELL PURPOSE:
(home, irrigation, municipal, industrial)

- WELL COMPLETION DATA:
- (1) diameter (inches) _____
 - (2) total depth (feet) _____
 - (3) static water level (feet) _____ below
top of ground. above
 - (4) casing _____ (material) _____ (depth) _____
_____ if telescope see back.
(size)
 - (5) screen _____ (length) _____ (depth to top) _____
(size) _____ (material)
 - (6) pump _____ (HP) _____ (yield gpm) _____
(type power) _____
 - (7) electric log _____ (yes or no) _____
(organization running log) _____
 - (8) how well bottom plugged _____

description of formations encountered	from	to
sand + hard clay	661	681
sand + clay	681	701
sand + clay 20' 8"	701	722
sand + clay 21' 9"	722	744
sand + clay 21' 9"	744	766
sand 22' 2"	766	788
sand 21' 8"	788	809
sand 21' 9"	809	831
sand 21' 8"	831	853
sand 21' 7"	853	874
sand 21' 11"	874	879
hard clay DR	879	889

TD 889'


JAN - 9 1970

MISS. BD. OF
WATER COMMISSIONERS

DRILLERS REMARKS: Rocks: 665'
889'

If well telescopes please sketch and show depths.

GROUND LEVEL

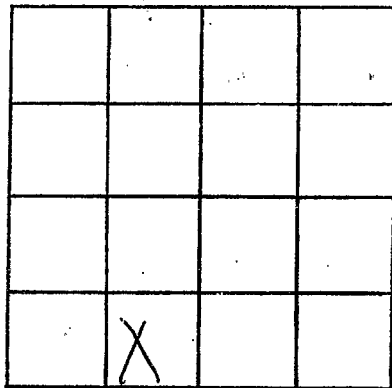

SECTION 14

Please indicate well location X.

ADDITIONAL INFORMATION

If more than one screen, show locations of each on sketch.