

TALLA.

MISSISSIPPI BOARD OF WATER COMMISSIONERS

0-8

5-10-65

WATER WELL DRILLERS LOG

CODED

Date: 5/10, 1965, Drillers: Della Wells & Sons, Tallahatchie County (Name)

(1) Owner of Land: J.C. Bufford (Name), Glendora (Address)
(2) Location: 1/4, 1/4, Sec. 19 T23R14W, 3 miles West of Glendora (distance, direction, Nearest Town)
(3) Topography: (Hilly) (Flat) (Level)
(4) Purpose of Well: Domestic (Domestic Irrigation, Municipal, Industrial, Other)

Table with 3 columns: Description & Color of Materials (Sand, Clay, Red Clay, Shell, etc.), Thickness Feet, Depth Feet. Rows include: Top soil, Fine sand, 1" gravel, Rocks, Clay & shale, etc.

Information upon completion of well:

(1) Diameter: 5 1/2 inches.
(2) Total Depth: 901 feet.
(3) Water Level: Flow feet below top of ground. approx 5 S.F.M.
(4) Cased to: Size
(5) Screen: Size 2 1/2, Length 20 ft.
(6) Were any formations sealed against pollution? yes, no.


If YES depth of formation
Why

Drillers Remarks:

Yield in G. P. M.: 60 G.P.M.

Type power: 5H P. Electrically Driven

Crops irrigated & Acreage:

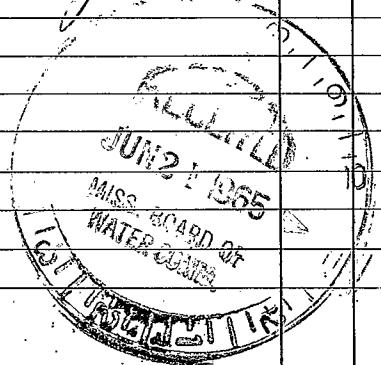

(Use Back Side)

Well No.

