

GW07035

15th

CODED

Tallahatchie
030
10-8-68

MISSISSIPPI
BOARD OF WATER COMMISSIONERS
416 North State Street
Jackson, Mississippi 39201

CODED

CODED

CODED

WATER WELL DRILLERS LOG

10/8/68
date well completed

19 Butane Gas Co. of Gwisd Tallahatchie
firm name county well located

LANDOWNER:

EQUEN PLANTING Co.
Minter City, Miss.
(mailing address)

description of formations encountered

from to

clay	0	30
SAND	30	40
SAND + GRAVEL	40	100

WELL LOCATION:

sec. 34 T 23 N R. 1 E
W
2 miles SW of Colona, MS
(distance) (direction) (nearest town)


WELL PURPOSE: CAT FISH
(home, irrigation, municipal, industrial)

WELL COMPLETION DATA:

- (1) diameter (inches) 12"
- (2) total depth (feet) 100
- (3) static water level (feet) 10 below above top of ground.
- (4) casing Steel, 60,
(material) (depth)
12"
(size) if telescope see back.
- (5) screen 40', 60
(length) (depth to top)
12", Steel
(size) (material)
- (6) pump 35 2000
(HP) (yield gpm)
LPGAS
(type power)
- (7) electric log No.
(yes or no)

(organization running log)
- (8) how well bottom plugged Welded Steel Plate

DRILLERS REMARKS:

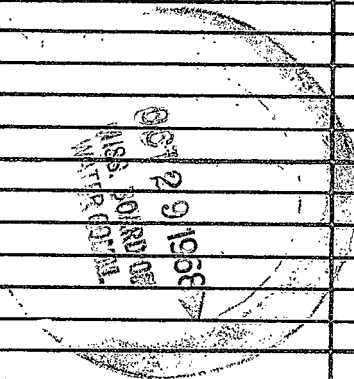

If well telescopes please sketch and show depths.

GROUND LEVEL

X			

SECTION 32

Please indicate well location X.

ADDITIONAL INFORMATION

If more than one screen, show locations of each on sketch.