

15H

CODED

CODED

Tallahatchie
031
10-11-68

MISSISSIPPI
BOARD OF WATER COMMISSIONERS
416 North State Street
Jackson, Mississippi 39201

WATER WELL DRILLERS LOG

10/11/68 date well completed
Butane Gas Co. of Good firm name
Tallahatchie county well located

LANDOWNER:
Eques Planting Co.
Minter City Miss.
(mailing address)


description of formations encountered	from	to
clay	0	32
Sand	30	40
Sand & GRAVE	40	108

WELL LOCATION:
sec 32 T 23 N R 1 E
SW W
1 1/2 miles SW of Glendora
(distance) (direction) (nearest town)

WELL PURPOSE: CAT FISH
(home, irrigation, municipal, industrial)

- WELL COMPLETION DATA:
- (1) diameter (inches) 12"
 - (2) total depth (feet) 108
 - (3) static water level (feet) 10 below top of ground.
 - (4) casing Steel, 68' (material) (depth)
12" (size) if telescope see back.
 - (5) screen 40', 68' (length) (depth to top)
12" (size) Steel (material)
 - (6) pump 35 (HP) 2000 (yield gpm)
LP Gas (type power)
 - (7) electric log No (yes or no)
(organization running log)
 - (8) how well bottom plugged Steel Plate

DRILLERS REMARKS:

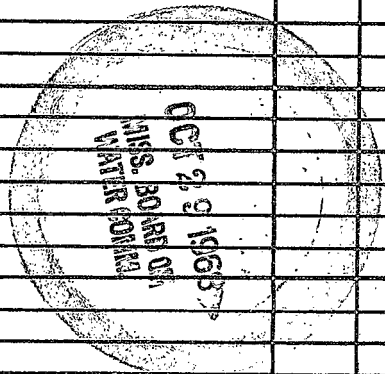

If well telescopes please sketch and show depths.

GROUND LEVEL

x			

SECTION 32

Please indicate well location X.

ADDITIONAL INFORMATION

If more than one screen, show locations of each on sketch.