

Tallahatchie
40
3-25-75

MISSISSIPPI
BOARD OF WATER COMMISSIONERS
416 North State Street
Jackson, Mississippi 39201

WATER WELL DRILLERS LOG

CODED

March 25, 1975 Singer-Layne Central Div. Tallahatchie
date well completed firm name county well located


LANDOWNER:	description of formations encountered	from	to
E. D. Graham Sumner, MS (mailing address)			
	Blue Clay	15	46
	Coarse Sand & Pea Gravel	46	73
	Coarse Sand	73	84
	Coarse Sand & Pea Gravel	84	106
	Coarse Sand & Gravel	106	109
WELL LOCATION:			
sec. 12 T 22N 23N R 7E 1W 4 miles north of Glendora (distance) (direction) (nearest town)			
WELL PURPOSE: irrigation (home, irrigation, municipal, industrial)			
WELL COMPLETION DATA:			
(1) diameter (inches) 16"			
(2) total depth (feet) 109'			
(3) static water level (feet) 10' below top of ground. above xxx			
(4) casing steel 49' (material) (depth) 16" (size) if telescope see back.			
(5) screen 60' 49' (length) (depth to top) 16" (size) steel (material)			
(6) pump 60 2800 (HP) (yield gpm) engine (type power)			
(7) electric log no (yes or no)			
(organization running log)			
(8) how well bottom plugged with plate			
DRILLERS REMARKS:			

RECEIVED

MAY 12 1975

If well telescopes please sketch and show depths.

GROUND LEVEL

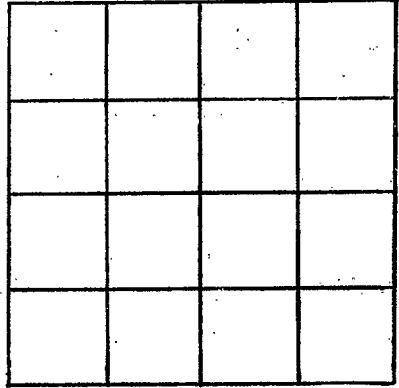

SECTION _____

Please indicate well location X.

ADDITIONAL INFORMATION

If more than one screen, show locations of each on sketch.