

Tallahatchie
 041
 2-67

MISSISSIPPI
 BOARD OF WATER COMMISSIONERS
 416 North State Street
 Jackson, Mississippi 39201

CODED

WATER WELL DRILLERS LOG

2-21-67 date well completed
 Fide County Farmers Assn firm name
 Tallahatchie county well located

LANDOWNER: BILLY Flauntt
Glendora
Miss
 (mailing address)

WELL LOCATION:
 sec. 15 T23 N R 1 W
1 miles S-SE of Savage Lake
 (distance) (direction) (nearest town)


WELL PURPOSE: drill
 (home, irrigation, municipal, industrial)

- WELL COMPLETION DATA:
- (1) diameter (inches) 6"
 - (2) total depth (feet) 110'
 - (3) static water level (feet) 18 6/8 below above top of ground.
 - (4) casing WW Casing 62'
 (material) (depth)
6" if telescope see back.
 (size)
 - (5) screen 48' 62'
 (length) (depth to top)
6" Daerr Screen
 (size) (material)
 - (6) pump Water 30" 1200
 (HP) (yield gpm)
 (type power)
 - (7) electric log NO
 (yes or no)
 (organization running log)
 - (8) how well bottom plugged Steel

description of formations encountered	from	to
Top Soil, Sandy Clay		14
Clay	13	27
Fine Sand	19 1/2	46 1/2
Coarse Sand	19 1/2	66"
Sand & Peas rock	26	92
Sand & large gravel	26	114"
SOLID Rock		114

CODED

DRILLERS REMARKS:

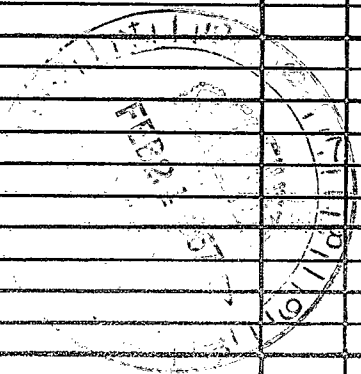

If well telescopes please sketch and show depths.

GROUND LEVEL

			X

SECTION 15

Please indicate well location X.

ADDITIONAL INFORMATION

If more than one screen,
show locations of each on sketch.