

Lallahatchie
042
10-67

MISSISSIPPI
 BOARD OF WATER COMMISSIONERS
 416 North State Street
 Jackson, Mississippi 39201

CODED

WATER WELL DRILLERS LOG

Oct 18 67 19 1967 Boone Co 7 Tallahatchie
 date well completed firm name county well located

LANDOWNER: DAN REYNOLDS
RT - Glendora, Miss
 (mailing address)

description of formations encountered	from	to
<u>CLAY</u>	<u>1</u>	<u>18</u>
<u>SAND & CLAY IN STREAKS</u>	<u>18</u>	<u>90</u>
<u>COARSE SAND & GRAVEL</u>	<u>90</u>	<u>115</u>


WELL LOCATION:
 sec. 34 T. 23 N. R. 1 E
1 miles SE of Glendora
 (distance) (direction) (nearest town)

WELL PURPOSE: Home
 (home, irrigation, municipal, industrial)

WELL COMPLETION DATA:

- (1) diameter (inches) 4"
- (2) total depth (feet) 116'
- (3) static water level (feet) 17 below top of ground.
- (4) casing 4" Galv, 105'
 (material) (depth)
4" if telescope see back.
 (size)
- (5) screen 11', 105'
 (length) (depth to top)
4", S. STEEL
 (size) (material)
- (6) pump 1 1/2 HP, 20
 (HP) (yield gpm)
ELECTREC
 (type power)
- (7) electric log No
 (yes or no)
 (organization running log)
- (8) how well bottom plugged Woods Plug & Back Pressure Valve


CODED

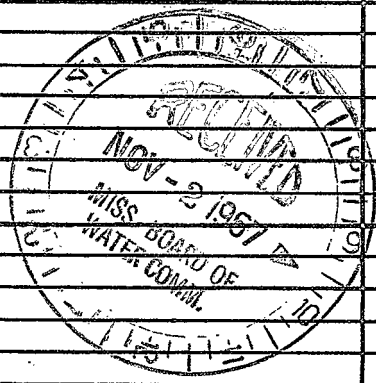

DRILLERS REMARKS:

If well telescopes please sketch and show depths.

GROUND LEVEL

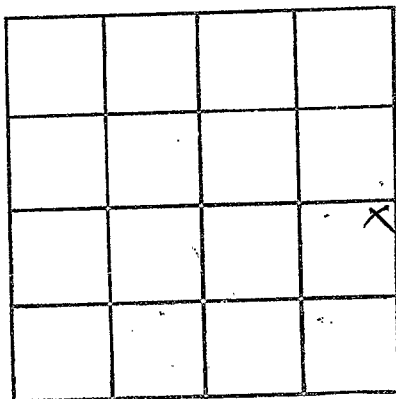

SECTION 34

Please indicate well location X.

ADDITIONAL INFORMATION

If more than one screen,
show locations of each on sketch.