

TALLAHATCHIE
 043
 3-68

MISSISSIPPI
 BOARD OF WATER COMMISSIONERS
 416 North State Street
 Jackson, Mississippi 39201

CODED

WATER WELL DRILLERS LOG

3-5-68 date well completed
 Butane Gas Co. of Greenwood firm name
 Tallahatchie county well located

LANDOWNER: Clifton Bishop
 B+S Planting Co.
 Glendora Miss.
 (mailing address)

description of formations encountered	from	to
clay	0	10
SAND & CLAY	10	90
SAND & GRAVEL	90	110


WELL LOCATION:
 sec. 28 T. 23 N. R. 1 E. W. 8
 1/2 miles N of Glendora
 (distance) (direction) (nearest town)

WELL PURPOSE: Home
 (home, irrigation, municipal, industrial)

CODED


- WELL COMPLETION DATA:
- (1) diameter (inches) 2"
 - (2) total depth (feet) 110'
 - (3) static water level (feet) 25' below top of ground.
 - (4) casing Steel 100' (material) (depth)
 2" (size) If telescope see back.
 - (5) screen 10' 100' (length) (depth to top)
 2" STAINLESS STEEL (size) (material)
 - (6) pump 3/4 5 (HP) (yield gpm)
 Elec. (type power)
 - (7) electric log NO (yes or no)
 (organization running log)
 - (8) how well bottom plugged
 BACKWASH VALVE

DRILLERS REMARKS:

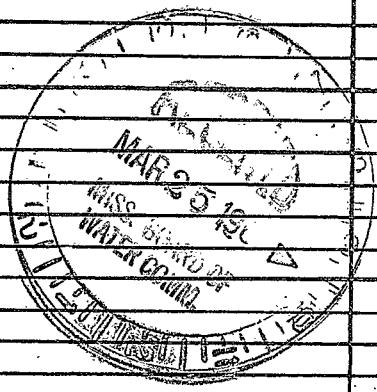

If well telescopes please sketch and show depths.

GROUND LEVEL

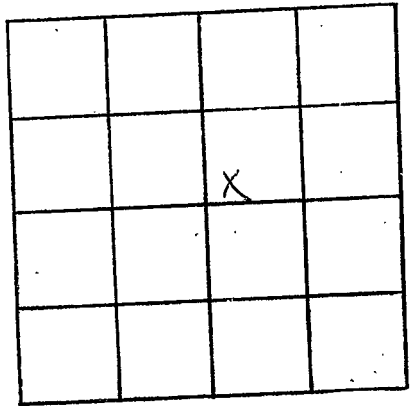

SECTION 28

Please indicate well location X.

ADDITIONAL INFORMATION

If more than one screen, show locations of each on sketch.