

TALLAHATCHIE
 044
 368
 MS-6W-03457

MISSISSIPPI
 BOARD OF WATER COMMISSIONERS
 416 North State Street
 Jackson, Mississippi 39201

CODED

WATER WELL DRILLERS LOG

3-20-68 date well completed
 Buttrave Gas Co. of Greenwood firm name
 Tallahatchie county well located

LANDOWNER:

M.P. Sturdivant Planting Co.
 Glendora, Miss.
 (mailing address)

description of formations encountered

from to

CLAY	0	18
SAND	18	40
SAND + GRAVEL	40	90

WELL LOCATION:

sec. 18 T 23 N R. 1 W
 2 1/2 miles NW of Glendora
 (distance) (direction) (nearest town)

WELL PURPOSE: IRRIGATION
 (home, irrigation, municipal, industrial)

WELL COMPLETION DATA:

(1) diameter (inches) 12"

(2) total depth (feet) 90

(3) static water level (feet) 18 below top of ground.

(4) casing Steel, 50' (material) (depth)
 12" (size) if telescope see back.

(5) screen 40' (length), 50' (depth to top)
 12" (size), Steel (material)

(6) pump 65 (HP), 2000 (yield gpm)

LP Gas Engine (type power)


(7) electric log No (yes or no)

(organization running log)

(8) how well bottom plugged Steel Plate


DRILLERS REMARKS:

CODED

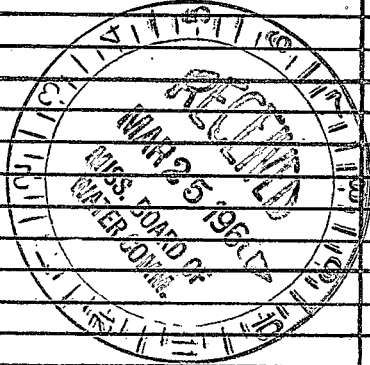

If well telescopes please sketch and show depths.

GROUND LEVEL

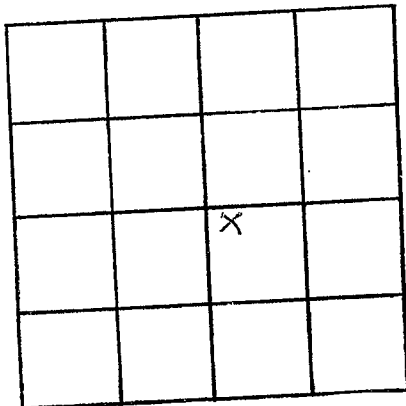

SECTION 18

Please indicate well location X.

ADDITIONAL INFORMATION

If more than one screen,
show locations of each on sketch.