

TALLAHATCHIE
 45
 4-68
 MS-GW-03447

MISSISSIPPI
 BOARD OF WATER COMMISSIONERS
 416 North State Street
 Jackson, Mississippi 39201

CODED

WATER WELL DRILLERS LOG

4-3-68 date well completed 19 Butane Gas Co. of Greenwood firm name Tallahatchie county well located

LANDOWNER: Mike Sturdivant
 M.P. Sturdivant Planting Co.
 Glendora Miss.
 (mailing address)

description of formations encountered	from	to
CLAY	0	25
FINE SAND	25	60
SAND + GRAVEL	60	107


WELL LOCATION:
 sec. 29 T 23 N R 1 E
 S W
 2 miles W of Glendora
 (distance) (direction) (nearest town)

WELL PURPOSE: IRRIGATION
 (home, irrigation, municipal, industrial)

CODED

WELL COMPLETION DATA:


- (1) diameter (inches) 12"
- (2) total depth (feet) 107
- (3) static water level (feet) 20 below top of ground.
- (4) casing steel, 67 (material), (depth)
 12 (size) if telescope see back.
- (5) screen 40' (length), 67 (depth to top)
 12" (size), steel (material)
- (6) pump 60 (HP), 2000 (yield gpm)
 LP GAS ENGINE (type power)
- (7) electric log NO (yes or no)
 (organization running log)
- (8) how well bottom plugged
 Steel Plate

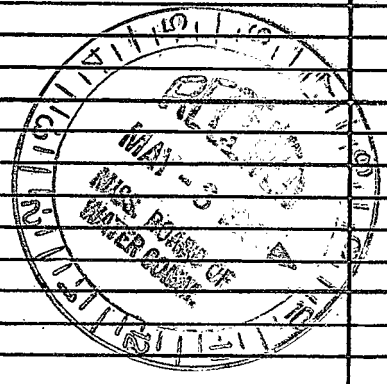

DRILLERS REMARKS:

If well telescopes please sketch and show depths.

GROUND LEVEL

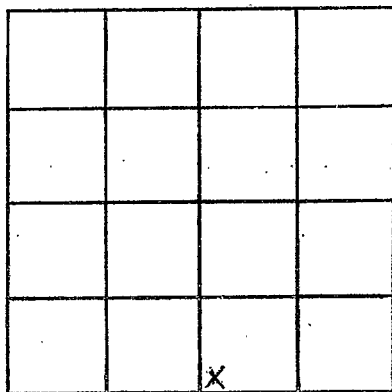

SECTION 29

Please indicate well location X.

ADDITIONAL INFORMATION

If more than one screen,
show locations of each on sketch.