

Tallahatchie
 046
 7-68

MISSISSIPPI
 BOARD OF WATER COMMISSIONERS
 416 North State Street
 Jackson, Mississippi 39201

CODED

WATER WELL DRILLERS LOG

7-19-68 19 Boutard Gas Co. of Wood Tallahatchie
 date well completed firm name county well located

LANDOWNER:
Ralph Hand
Glendora, Miss.
 (mailing address)

WELL LOCATION:
 sec. 18 T. 23 N. R. 1 E. S. 6 W.
3 miles W of Glendora
 (distance) (direction) (nearest town)

WELL PURPOSE: Home
 (home, irrigation, municipal, industrial)

description of formations encountered	from	to
Clay	0	14
SANDY + Clay	14	67
SAND + Gravel	67	135
Clay	135	168
SAND + SHALE	168	453
SHALE + Rock	453	687
SAND + SHALE	687	845
HARD "PACKED" SAND	845	882
SHALE	882	908

WELL COMPLETION DATA:

(1) diameter (inches) 4 7/8

(2) total depth (feet) 882

(3) static water level (feet) 10 below above top of ground.

(4) casing Steel, 862
 (material) (depth)

4 1/2 if telescope see back.
 (size)

(5) screen 20', 862
 (length) (depth to top)

2", Stainless Steel
 (size) (material)

(6) pump 1 20
 (HP) (yield gpm)


Elec.
 (type power)

(7) electric log No
 (yes or no)

(organization running log)

(8) how well bottom plugged
BACK PRESSURE VALVE

CODED

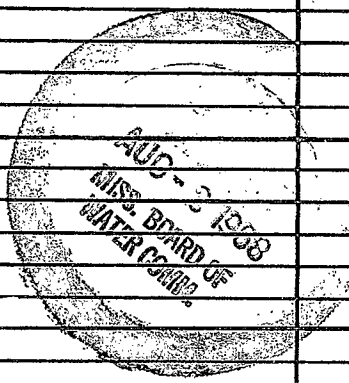

DRILLERS REMARKS: WG

