

CODED

Tallahatchie
Φ 48
8-8-75

MISSISSIPPI
BOARD OF WATER COMMISSIONERS
416 North State Street
Jackson, Mississippi 39201

WATER WELL DRILLERS LOG

8-8-75 156 **BUTANE GAS CO. OF GREENWOOD** Tallahatchie
date well completed firm name county well located

LANDOWNER:	description of formations encountered	from	to
L.H. Fedric FARM Glenora (mailing address)			
WELL LOCATION: sec. <u>34</u> T. <u>23</u> N R. <u>1 E</u> <u>3/4</u> miles <u>SE</u> of <u>Glenora</u> (distance) (direction) (nearest town)			
WELL PURPOSE: Home (home, irrigation, municipal, industrial)			
WELL COMPLETION DATA:			
(1) diameter (inches) <u>4x2</u>			
(2) total depth (feet) <u>835</u>			
(3) static water level (feet) <u>3</u> below above of ground.			
(4) casing <u>Steel</u> <u>805</u> (material) (depth) <u>4x2</u> if telescope see back. (size)			
(5) screen <u>30</u> <u>805</u> (length) (depth to top) <u>2"</u> <u>Stainless</u> (size) (material)			
(6) pump <u>2</u> <u>35</u> (HP) (yield gpm) <u>Elec.</u> (type power)			
(7) electric log <u>no</u> (yes or no)			
(organization running log)			
(8) how well bottom plugged <u>BACK PRESSURE VALVE</u>			
DRILLERS REMARKS:			

DISCOVERED
WATER

AUG 10 1975

MISS. BD. OF WATER COMMISSIONERS


If well telescopes please sketch and show depths.

GROUND LEVEL

105' - 4" CASING →

700' - 2" CASING →

90' - 2" SCREEN →

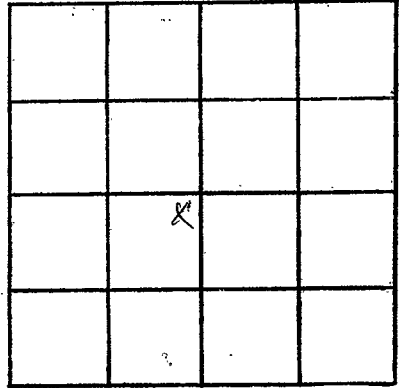

SECTION 3C

Please indicate well location X.

ADDITIONAL INFORMATION

If more than one screen, show locations of each on sketch.