

TALLAHATCHIE
 52
 8-29-77

MISSISSIPPI
 BOARD OF WATER COMMISSIONERS
 416 North State Street
 Jackson, Mississippi 39201

CODED

WATER WELL DRILLERS LOG

8-29 1977 Five County Farmen Tallahatchie
 date well completed firm name county well located

LANDOWNER: Jack Flauth

description of formations encountered	from	to
clay		10
med & sand	10	33
fine sand	33	45
course sand & br	45	100

(mailing address)

WELL LOCATION:

sec 4 T 23 N R 1 E
 S W
 3 1/2 miles S-E of Webb
 (distance) (direction) (nearest town)

CODED

WELL PURPOSE: domestic
 (home, irrigation, municipal, industrial)

WELL COMPLETION DATA:

- (1) diameter (inches) 8"
- (2) total depth (feet) 100'
- (3) static water level (feet) 24' ^{below} top of ground.
- (4) casing PVC, 60' (material) (depth)
 If telescope see back.
 (size)
- (5) screen 46' (length), 60' (depth to top)
 8" 50 slot PVC (size) (material)
- (6) pump 40 (HP), 1200 (yield gpm)
 direct (type power)
- (7) electric log no (yes or no)
- (organization running log)
- (8) how well bottom plugged


RECEIVED
 OCT 5 1977

DRILLERS REMARKS:

MISS. BD. OF WATER COMMISSIONERS

If well telescopes please sketch and show depths.

GROUND LEVEL

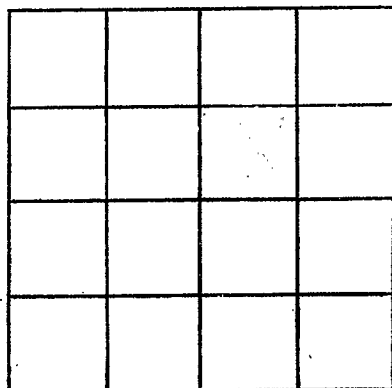

SECTION _____

Please indicate well location X.

ADDITIONAL INFORMATION

If more than one screen, show locations of each on sketch.