

TALLAHATCHIE
 53
 11/22/77

MISSISSIPPI
 BOARD OF WATER COMMISSIONERS
 416 North State Street
 Jackson, Mississippi 39201

CODED

WATER WELL DRILLERS LOG
 BUTANE GAS COMPANY
 OF GREENWOOD

Tallahatchie
 county well located

11-22-77 19
 date well completed

LANDOWNER:
 Buford Plantation
 Glendora
 (mailing address)

description of formations encountered	from	to
Clay	0	15
Sand	15	60
Sand & Gravel	60	97

WELL LOCATION:
 sec. 9 T. 23 N R. 1 E
 W
 1 miles SW of Swan Lake
 (distance) (direction) (nearest town)

WELL PURPOSE: IRR
 (home, irrigation, municipal, industrial)

CODED

WELL COMPLETION DATA:
 (1) diameter (inches) 16
 (2) total depth (feet) 97
 (3) static water level (feet) 18 below above top of ground.
 (4) casing Steel, 57, (material) (depth)
 16" If telescope see back. (size)
 (5) screen 40, 57 (length) (depth to top)
 16" Steel (size) (material)
 (6) pump 60, 2500 (HP) (yield gpm)
 Diesel (type power)
 (7) electric log no (yes or no)
 (organization running log)
 (8) how well bottom plugged Steel Plate

RECEIVED


DEC 2 1977

DRILLERS REMARKS:

MISS. BD. OF WATER COMM

If well telescopes please sketch and show depths.

GROUND LEVEL

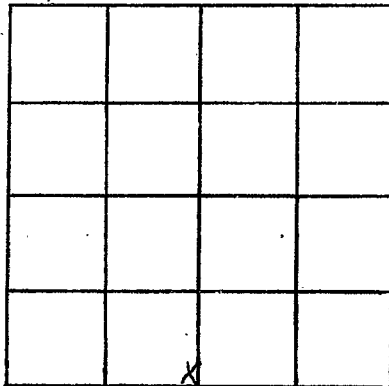

SECTION 9

Please indicate well location X.

ADDITIONAL INFORMATION

If more than one screen, show locations of each on sketch.