

TALLAHATCHIE

054

3/8/78

3/8/78

date well completed

MISSISSIPPI BOARD OF WATER COMMISSIONERS
416 North State Street
Jackson, Mississippi 39201

CODED

WATER WELL DRILLERS LOG
BUTANE GAS COMPANY

OF GREENWOOD

Tallahatchie
county well located

LANDOWNER:	description of formations encountered	from	to
Ralph Hand			
Glendora (mailing address)	CLAY	0	20
	SAND	20	30
	SAND & GRAVEL	30	100
WELL LOCATION:			
sec. 7 T. 23 N. R. 1 E 6 W			
4 1/2 miles SW of Glendora (distance) (direction) (nearest town)			
WELL PURPOSE: FRR (home, irrigation, municipal, industrial)			
WELL COMPLETION DATA:			
(1) diameter (inches) 16			
(2) total depth (feet) 100			
(3) static water level (feet) 18 below top of ground.			
(4) casing Steel, 60, (material) (depth) 16" (size) if telescope see back.			
(5) screen 40, 100 (length) (depth to top) 16 (size), steel (material)			
(6) pump 60 (HP), 2500 (yield gpm) Diesel (type power)			
(7) electric log NO (yes or no)			
(organization running log)			
(8) how well bottom plugged Steel Plate			
DRILLERS REMARKS:			


CODED

RECEIVED
MAR 23 1978

MISS. BD. OF WATER COMM

If well telescopes please sketch and show depths.

GROUND LEVEL

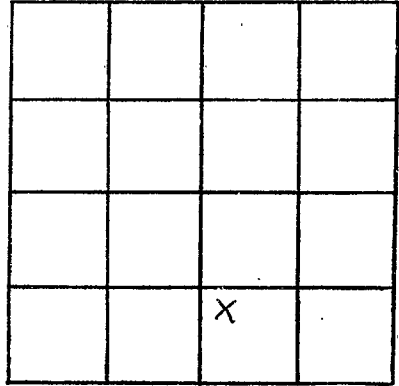

SECTION 7

Please indicate well location X.

ADDITIONAL INFORMATION

A series of horizontal lines for writing additional information.

If more than one screen, show locations of each on sketch.