

Tallahatchie

Q-55  
7/18/80  
564 18 19 80  
date well completed

MISSISSIPPI  
BOARD OF WATER COMMISSIONERS  
416 North State Street  
Jackson, Mississippi 39201

CODED

WATER WELL DRILLERS LOG  
BUTANE GAS COMPANY  
OF GREENWOOD

Tallahatchie  
~~Tallahatchie~~  
county well located

LANDOWNER: FEDRIC FARMS

Glendora Ms

(mailing address)

WELL LOCATION:

sec 34 T 23 N R 1 E  
1/2 miles EAST of Glendora  
(distance) (direction) (nearest town)

WELL PURPOSE: HOME  
(home, irrigation, municipal, industrial)

WELL COMPLETION DATA:

- (1) diameter (inches) 4 1/2"
- (2) total depth (feet) 818
- (3) static water level (feet) 3' below top of ground.
- (4) casing STEEL, 798  
" (material) (depth)  
4x2" (size) if telescope see back.
- (5) screen 20', 798  
(length) (depth to top)  
2", STAINLESS  
(size) (material)
- (6) pump 1, 20  
(HP) (yield gpm)  
ELEC  
(type power)
- (7) electric log No  
(yes or no)  
No  
(organization running log)

(8) has well bottom plugged BACK PRESSURE VALVE

DRILLERS REMARKS:

description of formations encountered	from	to
CLAY	1	25
SAND	25	70
SAND & GRAVEL	70	130
CLAY	130	190
SAND	190	320
SAND SHALE & Rock	320	600
SAND	600	720
CLAY	720	770
SAND	770	822

DEPT. OF NATURAL RESOURCES  
BUREAU OF LAND & WATER RESOURCES

JUL 28 1980  
RECEIVED


If well telescopes please sketch and show depths.

GROUND LEVEL

105' 4" STEEL CASING

693' 2" STEEL CASING

20' STAINLESS SCREEN

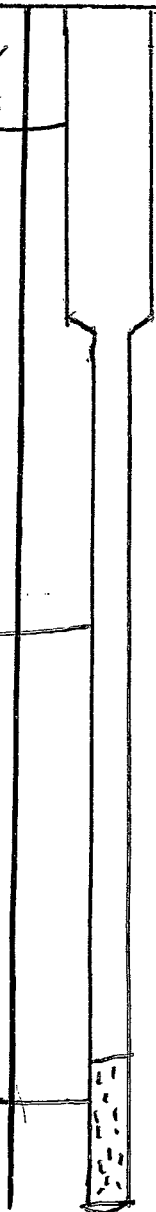

		X	

SECTION 34

Please indicate well location X.

ADDITIONAL INFORMATION

If more than one screen, show locations on sketch.