

MISSISSIPPI DEPARTMENT OF NATURAL RESOURCES

Bureau of Land and Water Resources

Southport Mall

P.O. Box 10631

CODED

Jackson, Mississippi 39209

WATER WELL DRILLERS LOG

BUTANE GAS COMPANY

OF GREENWOOD

firm name

Tallahatchie
county well located

TALLAHATCHIE
058
2/28/83

2-28 1983
date well completed

LANDOWNER:	description of formations encountered	from	to
<p><u>M. P. Sturdivant</u></p> <p>(mailing address)</p>	<p><u>Clay</u></p> <p><u>Sand</u></p> <p><u>Sand + Gravel</u></p>	<p><u>0</u></p> <p><u>15</u></p> <p><u>50</u></p>	<p><u>15</u></p> <p><u>80</u></p> <p><u>103</u></p>
<p>WELL LOCATION:</p> <p>sec. <u>19</u> T <u>23</u> N R <u>2</u> W</p> <p><u>2 1/2</u> miles <u>SW</u> of <u>GLENDORA</u></p> <p>(distance) (direction) (nearest town)</p>			
<p>WELL PURPOSE: <u>Irrigation</u></p> <p>(home, irrigation, municipal, industrial)</p>			
<p>WELL COMPLETION DATA:</p> <p>(1) diameter (inches) <u>16"</u></p> <p>(2) total depth (feet) <u>103</u></p> <p>(3) static water level (feet) <u>15</u> ^{below} _{above} top of ground.</p> <p>(4) casing <u>Steel, 63'</u> (material) (depth)</p> <p><u>16"</u> (size) if telescope see back.</p> <p>(5) screen <u>40'</u>, <u>63'</u> (length) (depth to top)</p> <p><u>16"</u>, <u>Steel</u> (size) (material)</p> <p>(6) pump <u>60</u> <u>1500</u> (HP) (yield gpm)</p> <p><u>Diesel</u> (type power)</p> <p>(7) electric log <u>No</u> (yes or no)</p> <p><u>No</u> (organization running log)</p> <p>(8) how well bottom plugged <u>Steel plate</u></p>			
<p>DRILLERS REMARKS:</p> <p><u>Carles K...</u></p>			


DEPT. OF NATURAL RESOURCES
BUREAU OF LAND & WATER RESOURCES

MAR 29 1983

RECEIVED

If well telescopes please sketch and show depths.

GROUND LEVEL

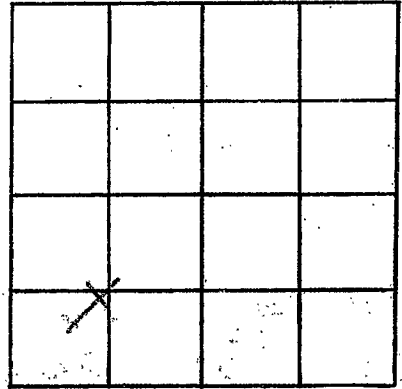

SECTION 19

Please indicate well location X.

ADDITIONAL INFORMATION

If more than one screen, show locations of each on sketch.