

MISSISSIPPI DEPARTMENT OF NATURAL RESOURCES

Bureau of Land and Water Resources

Southport Mall

P.O. Box 10631

CODED

Jackson, Mississippi 39209

WATER WELL DRILLERS LOG

BUTANE GAS COMPANY

OF GREENWOOD

Tallahatchie
county well located

TALLAHATCHIE
059
2/21/83

2-21-83
date well completed

LANDOWNER:

Sykes Hardaway

description of formations encountered

description of formations encountered	from	to
CLAY	0	10
Sand	10	30
SAND & GRAVEL	30	93

Glendon
(mailing address)

WELL LOCATION:

sec. 30 T 23 N R 1 E
3.5 miles E of Glendon
(distance) (direction) (nearest town)

WELL PURPOSE: Irrigation
(home, irrigation, municipal, industrial)

WELL COMPLETION DATA:

- diameter (inches) 12"
- total depth (feet) 93
- static water level (feet) 80 below top of ground.
- casing Steel 53 (material), (depth)
12" (size) if telescope see back.
- screen 40 53 (length), (depth to top)
12" (size), Steel (material)
- pump 60 600 (HP) (yield gpm)
Diesel (type power)
- electric log No (yes or no)
No (organization running log)
- how well bottom plugged Steel plate

DEPT. OF NATURAL RESOURCES
BUREAU OF LAND & WATER RESOURCES

MAR 29 1983


DRILLERS REMARKS:

Charles Ramos

RECEIVED

If well telescopes please sketch and show depths.

GROUND LEVEL

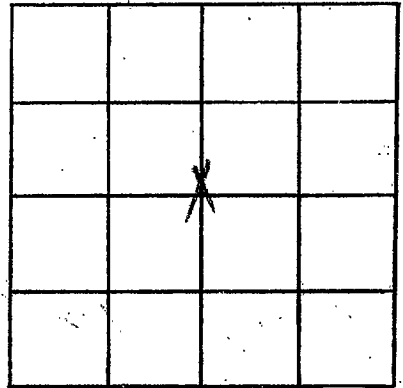

SECTION 30

Please indicate well location X.

ADDITIONAL INFORMATION

If more than one screen,
show locations of each on sketch.